


STATE OF KANSAS
STATE CORPORATION COMMISSION

WELL PLUGGING RECORD

Give All Information Completely
Make Required Affidavit
Mail or Deliver Report to:
Conservation Division
State Corporation Commission
211 No. Broadway
Wichita, Kansas

Harper County. Sec. 6 Twp 35s Rge. 8W (E) (W)
Location as "NE/CNW/SW" or footage from lines ctr-NW-NW-SE
Lease Owner J.M. Huber Corp.
Lease Name Jones Well No. 1
Office Address Box 978 Liberal, Kansas
Character of Well (completed as Oil, Gas or Dry Hole) Dry hole
Date well completed 7-17 19 56
Application for plugging filed 7-17 19 56
Application for plugging approved 7-17 19 56
Plugging commenced 7-17 19 56
Plugging completed 7-17 19 56
Reason for abandonment of well or producing formation _____

NORTH

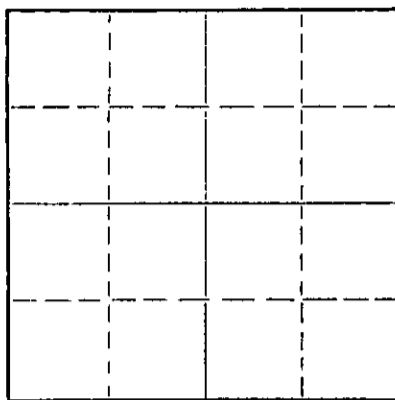

Locate well correctly on above
Section Plat

If a producing well is abandoned, date of last production _____ 19 ____
Was permission obtained from the Conservation Division or its agents before plugging was commenced? Yes

Name of Conservation Agent who supervised plugging of this well M.A. Rives
Producing formation _____ Depth to top _____ Bottom _____ Total Depth of Well 4892 Feet
Show depth and thickness of all water, oil and gas formations.

OIL, GAS OR WATER RECORDS

CASING RECORD

FORMATION	CONTENT	FROM	TO	SIZE	PUT IN	PULLED OUT
				9 5/8	240'	None

Describe in detail the manner in which the well was plugged, indicating where the mud fluid was placed and the method or methods used in introducing it into the hole. If cement or other plugs were used, state the character of same and depth placed, from _____ feet to _____ feet for each plug set.

Filled hole w/ mud to 235'. Halliburton plug at 235' w/ 1/2 sx. Halls. Spotted 35 sx. cement thru D.P. Filled w/ mud to 35'. Spotted Halliburton plug w/ 1/2 sx. Halls of 35'. Filled to surface w/ 10 sx. cement.

RECEIVED
STATE CORPORATION COMMISSION
JUL 21 1956
7-21-56
CONSERVATION DIVISION
WICHITA, KANSAS

(If additional description is necessary, use BACK of this sheet)

Name of Plugging Contractor G-M. Drlg. Co.
Address P.O. Box 1033, Wichita, Kansas

STATE OF Kansas, COUNTY OF Seward, ss.
W.W. Henson (employee of owner) or (owner or operator) of the above-described well, being first duly sworn on oath, says: That I have knowledge of the facts, statements, and matters herein contained and the log of the above-described well as filed and that the same are true and correct. So help me God.

(Signature) W.W. Henson
Box 978 Liberal, Kansas
(Address)

SUBSCRIBED AND SWORN TO before me this 20th day of July, 19 56

My commission expires 5-18-60 Rafael Clark Notary Public.

PLUGGING
FILE SEC 6 T 35 R 8W
BOOK PAGE 81 LINE 31

JONES #1

Well Record

Location: NW/4 NW/4 SE/4 Sec. 6-358-2W Harper County, Kansas
 Commenced: June 28, 1956
 Completed: July 17, 1956 (rotary)

Operator: J. M. Huber Corporation
 P. O. Box 881
 Berger, Texas

Contractor: Graham-Michaelis Drilling Company
 1955 East Second Street
 Wichita 1, Kansas

Casing Record: 9-5/8" @ 240' w/250 sacks Pennix cement

LOG

Sand & Red Bed	240
Red Bed, Shale & Gyp.	1382
Lime & Shale	1600
Shale & Shells	1882
Lime & Shale	3872
Lime & Sand	3905
Shale & Lime	3995
Lime	4080
Lime & Shale	4270
Lime	4634
Lime & Shale	4858
Lime	4892, RTD

STATE OF KANSAS)
) ss.
 COUNTY OF REDGWICK)

The undersigned, GRAHAM-MICHAELIS DRILLING COMPANY, hereby certifies that the above log is a true and correct log of the formations encountered in drilling the above well as reflected by the Daily Drilling Report.

GRAHAM-MICHAELIS DRILLING COMPANY

By John L. James
 John L. James
 Geologist.

Subscribed and sworn to before me this 28rd day of July, 1956.

Mary L. Barnes

My commission expires: 11/7/57.

PLUGGING
 FILE SEC. 6 T. 35 R. 8W
 BOOK PAGE 81 LINE 31

RECORDED