


WELL PLUGGING RECORD

Give All Information Completely
Make Required Affidavit
Mail or Deliver Report to:
Conservation Division
State Corporation Commission
800 Biting Building
Wichita, Kansas

Ness County, Sec. 15 Twp. 19 Rge. (E) 21 (W)
Location as "NE/CNW $\frac{1}{4}$ SW $\frac{1}{4}$ " or footage from lines SW SW SW
Lease Owner Harry Gore
Lease Name Brentz Well No. 1
Office Address 400 Brown Building, Wichita, Kansas
Character of Well (completed as Oil, Gas or Dry Hole) Dry Hole
Date well completed May 3, 19 51
Application for plugging filed May 3, 19 51
Application for plugging approved May 3, 19 51
Plugging commenced May 3, 19 51
Plugging completed May 3, 19 51
Reason for abandonment of well or producing formation.

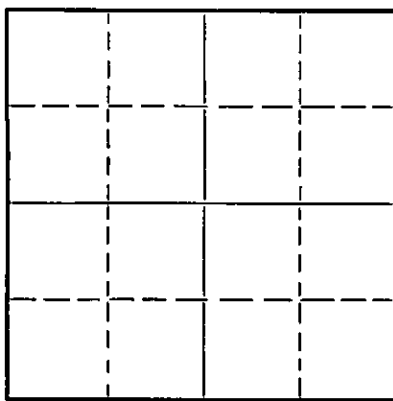

If a producing well is abandoned, date of last production 19
Was permission obtained from the Conservation Division or its agents before plugging was commenced? Yes

Name of Conservation Agent who supervised plugging of this well C. D. Stough, Great Bend, Kansas
Producing formation Depth to top Bottom Total Depth of Well 4492 Feet
Show depth and thickness of all water, oil and gas formations.

OIL, GAS OR WATER RECORDS

CASING RECORD

Formation	Content	From	To	Size	Put In	Pulled Out
				8-5/8"	306'	Cemented

Describe in detail the manner in which the well was plugged, indicating where the mud fluid was placed and the method or methods used in introducing it into the hole. If cement or other plugs were used, state the character of same and depth placed, from feet to feet for each plug set.

Set plug at 300' with 20 sacks of cement.
Set second plug at 40' and cemented to the ground.

05-12-1951

(If additional description is necessary, use BACK of this sheet)

Correspondence regarding this well should be addressed to Harry Gore
Address 400 Brown Building
Wichita, Kansas

STATE OF KANSAS, COUNTY OF MONTGOMERY, ss.

FLOYD W. HILD, (employee of owner) or (owner or operator) of the above-described well, being first duly sworn on oath, says: That I have knowledge of the facts, statements, and matters herein contained and the log of the above-described well as filed and that the same are true and correct. So help me God. THE BREEDER SUPPLY & DEVELOPMENT COMPANY

(Signature) Floyd W. Hild

P. O. Box 201, Cherryvale, Kansas (Address)

SUBSCRIBED AND SWORN to before me this 10th day of May, 19 51

Leo Lawson
Notary Public.

My commission expires July 11, 1952.

PLUGGING
FILE SEC 15 T 19 R 21 W
BOOK PAGE 80 LINE 2

15-135-00038-00-00

Company Harry Gore

Sec. 15 T. 19 R. 21
 Loc. Southwest Quarter (S. 1/4)
 County Leas - Kansas

Farm Brentz

No. 1

Total Depth 4492'

Comm. 4-14-51

Comp. 5-3-51

Shot or Treated


Contractor Veeder Supply Company

Drilled with Rig - D

Issued

No. of Days - 20

No. of Bits -

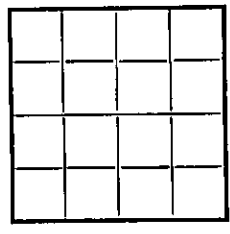

Casing

20 in. 10 in
 15 1/2 8 1/4
 12 1/2 6 5/8
 13 3/8 5 3/16

Set 306' of 8-5/8" Casing Cemented with 200 sacks cement.

Elevation

Production

Figures Indicate Bottom of Formation

Clay Rock	0	30	30
Sand Shale	30	50	20
Shale Shells	50	306	256
Sandy Shale	306	370	64
Sand	370	450	80
Blue Shale	450	570	120
Shale Shells	570	735	165
Red Red	735	785	50
Anhydrite	785	815	30
Red Shale	815	885	70
Sand Shale	885	1150	265
Shale	1150	1260	110
Shale Red Rock	1260	1465	205
Lime Shale Shells	1465	1480	15
Sandy Lime	1480	1500	20
Shale Red Rock Shells	1500	1650	150
Shale Shells	1650	1755	105
Lime Shale	1755	1800	45
Shale Shells	1800	1890	90
Shale Shells Salt	1890	2020	130
Shale Lime Shells	2020	2040	20
Shale Shells Sandy	2040	2160	120
Shale Shells	2160	2210	50
Lime Shale	2210	2606	396
Shale	2606	2615	9
Lime Shale	2615	2760	145
Lime	2760	2805	45
Lime Shale	2805	3422	617
Lime	3422	3445	23
Lime Shale	3445	3520	75
Lime	3520	4306	786
Lime Shale	4306	4335	29
Conglomerate	4335	4390	55
Lime Cherty	4390	4492	102
Total Depth	4492'		

Tops:

Reebrer	- 3739
Brown Line	- 3767
Lansing H.G.	- 3785
Base H.G.	- 4058
Cherty Conglomerate	- 4351
iso. Cherty	- 4387

Plugged @ 300' used 200 sacks cement.
 Plug @ 40' cemented to ground surface.

*Rec'd
 05-12-1951*

15. 19 810
 80
 BOOK PAGE