


Give All Information Completely
Make Required Affidavit
Mail or Deliver Report to:
Conservation Division
State Corporation Commission
211 No. Broadway
Wichita, Kansas

WELL PLUGGING RECORD

NORTH

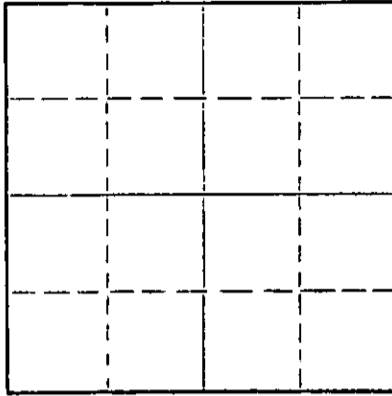

Locate well correctly on above
Section Plat

Ness County, Sec. 16 Twp. 19S Rge. 21W (E) (W)

Location as "NE/CNWxSWx" or footage from lines C NW SE
Lease Owner Walters Drilling Co. & Ferguson Oil Co.
Lease Name Wilhelm Well No. 1
Office Address 510 Orpheum Building, Wichita, Kansas
Character of Well (completed as Oil, Gas or Dry Hole) Dry Hole
Date well completed 2-18-64 19
Application for plugging filed 2-18-64 19
Application for plugging approved 2-18-64 19
Plugging commenced 2-18-64 19
Plugging completed 2-18-64 19

Reason for abandonment of well or producing formation
commercial quantities of oil not found

If a producing well is abandoned, date of last production _____ 19

Was permission obtained from the Conservation Division or its agents before plugging was commenced? yes

Name of Conservation Agent who supervised plugging of this well Eldon Petty

Producing formation _____ Depth to top _____ Bottom _____ Total Depth of Well 4400 Feet

Show depth and thickness of all water, oil and gas formations.

OIL, GAS OR WATER RECORDS

CASING RECORD

FORMATION	CONTENT	FROM	TO	SIZE	PUT IN	PULLED OUT
				8 5/8"	495	

Describe in detail the manner in which the well was plugged, indicating where the mud fluid was placed and the method or methods used in introducing it into the hole. If cement or other plugs were used, state the character of same and depth placed, from _____ feet to _____ feet for each plug set.

Bottom plug @ 490 w/ 25 sks. cement
Top plug @ 40' w/ 10 sks. cement

RECEIVED
STATE CORPORATION COMMISSION

FEB 25 1964

CONSERVATION DIVISION
Wichita, Kansas

02-25-1964

(If additional description is necessary, use BACK of this sheet)

Name of Plugging Contractor Walters Drilling Co.
Address 510 Orpheum Building, Wichita, Kansas

STATE OF KANSAS, COUNTY OF SEDGWICK, ss.

Robert F. Walters (~~owner~~) or (~~owner~~) of the above-described well, being first duly sworn on oath, says: That I have knowledge of the facts, statements and matters herein contained and the log of the above-described well as filed and that the same are true and correct. So help me God.

(Signature) Robert F. Walters

510 Orpheum Building, Wichita 2, Kansas
(Address)

SUBSCRIBED AND SWORN to before me this 21st day of February, 19 64

My commission expires October 4, 1967



Juanita M. Green
Notary Public.

15-135 - 00335-00-00

DRILLER'S LOG

COMPANY: WALTERS DRILLING CO. & FERGUSON OIL CO.
 510 Orpheum Building & 522 Union Center
 Wichita, Kansas

WELL NAME: WILHELM #1
 C NW SE SEC. 16-19S-21W
 NESS COUNTY, KANSAS

CONTRACTOR: WALTERS DRILLING CO.
 510 Orpheum Building
 Wichita, Kansas

ROTARY DRILLING COMMENCED: February 6, 1964
 ROTARY DRILLING COMPLETED: February 18, 1964

ELEVATION: 2260 KB
 2257 DF
 2255 GL

CASING RECORD: 8 5/8" @ 495' w/ 250 sacks cement


LOG

0 - 20	Surface Sand
20 - 170	Sand w/ Shale
170 - 380	Shale
380 - 450	Sand
450 - 625	Shale
625 - 910	Shale and Red Bed
910 - 1220	Sand and Shale
1220 - 1410	Shale
1410 - 1460	Red Bed
1460 - 1496	Anhydrite
1496 - 1710	Shale
1710 - 2270	Shale
2270 - 2435	Shale and Lime
2435 - 3370	Lime and Shale
3370 - 3490	Shale and Lime
3490 - 3660	Lime and Shale
3660 - 3740	Lime
3740 - 3800	Lime and Shale
3800 - 4140	Lime
4140 - 4185	Lime and Shale
4185 - 4305	Lime
4305 - 4325	Lime and Shale
4325 - 4380	Lime
4380 - 4385	Lime and Chert
4385 - 4400	Lime
<u>4400</u>	<u>Rotary Total Depth - D & A</u>

RECEIVED
 STATE CORPORATION COMMISSION

FEB 25 1964
 02-25-1964
 CONSERVATION DIVISION
 Wichita, Kansas

The undersigned, Robert F. Walters, hereby certifies, in behalf of said company that the above log is a true and correct log of the formations encountered in drilling the above well as reflected by the Daily Drilling Reports.

WALTERS DRILLING CO.

 ROBERT F. WALTERS, Partner

STATE OF KANSAS)
) SS.
 COUNTY OF SEDGWICK)

BE IT REMEMBERED, that, on this 21st day of February, 1964, before me, the undersigned, a Notary Public duly commissioned in and for the State and County aforesaid, came Robert F. Walters, known to me to be the same person who executed the foregoing instrument as Partner and in behalf of the Walters Drilling Co. and he duly acknowledged the execution of the same for himself and for said company.

IN WITNESS WHEREOF, I have hereunto set my hand and official seal on the day and year last above written.

My Commission Expires: October 4, 1967

