


STATE OF KANSAS  
STATE CORPORATION COMMISSION

WELL PLUGGING RECORD

Give All Information Completely  
Make Required Affidavit  
Mail or Deliver Report to  
Conservation Division  
State Corporation Comm.  
245 North Water  
Wichita, KS 67202

Ness County, Sec. 16 Twp. 19S Rge. 21W ExW  
Location as "NE/CNW $\frac{1}{4}$ SW $\frac{1}{4}$ " or footage from lines  
100' NW of NE SW NE  
Lease Owner Mark Babich  
Lease Name Wilhelm Well No. 1  
Office Address P.O. Box 2817, Wichita, Kansas 67201  
Character of Well (Completed as Oil, Gas or Dry Hole)

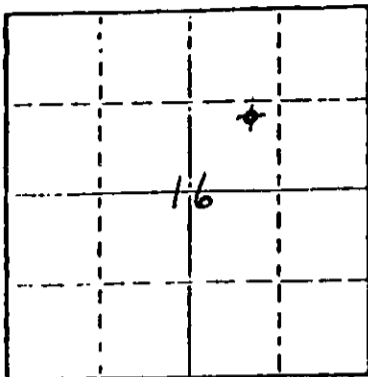

Locate well correctly on above  
Section Plot

Dry Hole  
Date Well completed January 23, 19 81  
Application for plugging filed January 23, 19 81  
Application for plugging approved January 23, 19 81  
Plugging commenced January 23, 19 81  
Plugging completed January 23, 19 81  
Reason for abandonment of well or producing formation

Dry Hole  
If a producing well is abandoned, date of last production 19

Was permission obtained from the Conservation Division or its agents before plugging was commenced? Yes

Name of Conservation Agent who supervised plugging of this well Leo F. Massey  
Producing formation \_\_\_\_\_ Depth to top \_\_\_\_\_ Bottom \_\_\_\_\_ Total Depth of Well 4402'  
Show depth and thickness of all water, oil and gas formations.

OIL, GAS OR WATER RECORDS

CASING RECORD

FORMATION	CONTENT	FROM	TO	SIZE	PUT IN	PULLED OUT
		0'	357'	8-5/8"	350'	None

Describe in detail the manner in which the well was plugged, indicating where the mud fluid was placed and the method or methods used in introducing it into the hold. If cement or other plugs were used, state the character of same and depth placed, from \_\_\_\_\_ feet to \_\_\_\_\_ feet for each plug set.

Plugged with 70 sacks cement at 950';  
30 sacks cement at 360'; 10 sacks cement  
at 40'; and 10 sacks cement in rat hole.  
(50-50 Pozmix Cement, 6% Gel)

(If additional description is necessary, use BACK of this sheet)


Name of Plugging Contractor Allied Cementing Co.

STATE OF KANSAS COUNTY OF SEDGWICK, ss.  
John D. Knightley Agent (employee of owner) or (owner or operator)  
of the above-described well, being first duly sworn on oath, says: That I have knowledge of the facts, statements, and matters herein contained and the log of the above-described well as filed and that the same are true and correct. So help me God.

(Signature) [Signature]  
221 S. Broadway, Suite 400, Wichita, KS 67202  
(Address)

SUBSCRIBED AND SWORN TO before me this 11th day of February, 19 81

My commission expires March 12, 1983

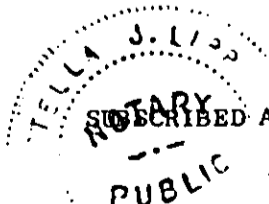

[Signature]  
Notary Public.

FEB 12 1981  
02-12-1981  
CONSERVATION DIVISION

15-135-21927-00-00

Mark Babich  
P.O. Box 2817  
Wichita, Kansas 67201

- Wilhelm #1  
100' NW of NE SW NE  
Section 16-19S-21W  
Ness County, Kansas

Contractor: D. R. Lauck Oil Company, Inc.  
221 S. Broadway, Suite 400  
Wichita, Kansas 67202

Commenced: January 17, 1981  
Completed: January 23, 1981

Drillers Log

Post Rock	90
Blue Shale	640
Shale	844
Anhydrite	852
Red Bed & Sand	1550
Shale	1853
Shale & Shells	2970
Shale & Lime	3200
Shale & Shells	3400
Shale & Lime	4100
Lime	4300
Lime & Shale	4392
Chert & Lime	4402 RTD

FEB 12 1981  
02-12-1981  
CO: [unclear]  
Wichita, Kansas