

15-135-20471-00-00

STATE OF KANSAS  
STATE CORPORATION COMMISSION


Form CP-4

Give All Information Completely  
Make Required Affidavit  
Mail or Deliver Report to:  
Conservation Division  
State Corporation Commission  
212 No. Market  
Wichita, Kansas 67202

WELL PLUGGING RECORD

Ness County, Sec. 23 Twp. 19S Rge. (E) 21 (W)

Location as "NE/CNW/SW" or footage from lines C NW SE  
Lease Owner Leben Oil Corporation  
Lease Name Antenen Well No: #1  
Office Address 200 West Douglas Wichita, Kansas 67202  
Character of Well (completed as Oil, Gas or Dry Hole) Dry Hole  
Date well completed ~~August 9~~ Sept. 9 19 71  
Application for plugging filed ~~August 9~~ Sept. 9 19 71  
Application for plugging approved ~~August 9~~ Sept. 9 19 71  
Plugging commenced ~~August 9~~ Sept. 9 19 71  
Plugging completed ~~August 9~~ Sept. 9 19 71  
Reason for abandonment of well or producing formation Dry Hole

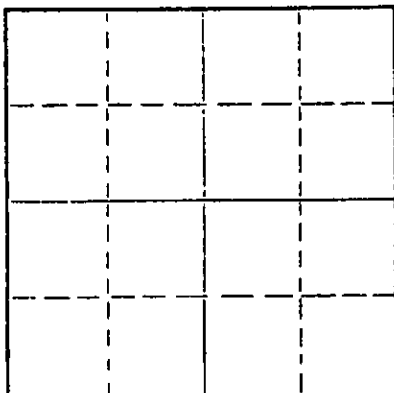

Locate well correctly on above  
Section Plat

If a producing well is abandoned, date of last production \_\_\_\_\_ 19\_\_\_\_  
Was permission obtained from the Conservation Division or its agents before plugging was commenced? Yes

Name of Conservation Agent who supervised plugging of this well Leo Massey  
Producing formation \_\_\_\_\_ Depth to top \_\_\_\_\_ Bottom \_\_\_\_\_ Total Depth of Well 4480' Feet  
Show depth and thickness of all water, oil and gas formations.

OIL, GAS OR WATER RECORDS

CASING RECORD

FORMATION	CONTENT	FROM	TO	SIZE	PUT IN	PULLED OUT
				8 5/8"	370	-0-

Describe in detail the manner in which the well was plugged, indicating where the mud fluid was placed and the method or methods used in introducing it into the hole. If cement or other plugs were used, state the character of same and depth placed, from \_\_\_\_\_ feet to \_\_\_\_\_ feet for each plug set.

Plugged @ 800' w/70 sacks  
Plugged @ 360' w/25 sacks  
Plugged top plug 1/2 sack Hulls Plug & 10 sacks

RECEIVED  
STATE CORPORATION COMMISSION  
SEP 23 1971  
CONSERVATION DIVISION  
Wichita, Kansas  
9-23-71

(If additional description is necessary, use BACK of this sheet)

Name of Plugging Contractor Leben Drilling Inc.  
Address 100 Park Ave. Bldg. Oklahoma City, Oklahoma 73102

STATE OF Oklahoma, COUNTY OF Oklahoma, ss.  
Lestie Kite (employee of owner) or (owner or operator) of the above-described well, being first duly sworn on oath, says: That I have knowledge of the facts, statements, and matters herein contained and the log of the above-described well as filed and that the same are true and correct. So help me God.

(Signature) Lestie Kite

(Address)

SUBSCRIBED AND SWORN TO before me this 20 day of Sept., 19 71

My commission expires 4-29-75

Jarvis DeLong  
Notary Public.

WELL LOG

15-135-20471-00-00

Company Leben Oil Corporation

Sec. 23 T.19S R.21W

Contractor Leben Drilling, Inc.

Loc. C NW SE

Farm Antenen #1

County Ness


Total Depth 4480'

Casing 8 5/8"

Commenced 8-30-71

Production

Completed 9-9-71

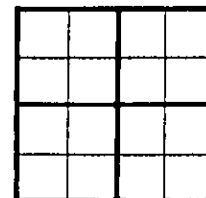

Figures Indicate Bottom of Formations

0'	-	40'	clay
40'	-	200'	clay - sd - sh
200'	-	280'	sd
280'	-	370'	sd - sh
370'	-	960'	sh
960'	-	1220'	sd
1220'	-	1536'	sh
1536'	-	1565'	anhy
1565'	-	1680'	sh
1680'	-	2285'	sh & lm
2285'	-	3586'	lm & sh
3586'	-	4385'	lm
4385'	-	4421'	lm & chert
4421'	-	4425'	miss.
4425'	-	4430'	lm
4430'	-	4480'	miss.

RECEIVED  
 STATE CORPORATION COMMISSION  
 SEP 23 1971  
 CONSERVATION DIVISION  
 Wichita, Kansas  
 09-23-1971

State of Oklahoma }  
 County of Oklahoma } SS

I, Leslie Kite of Leben Drilling, Inc., upon oath state that the above and foregoing is a true and correct copy of the log of the Antenen #1 Well.

Leslie Kite

Subscribed and sworn to before me this 20th day of Sept, 1971

My Commission Expires: 4-27-75 Jackie Rivers