
STATE OF KANSAS
STATE CORPORATION COMMISSION

Give All Information Completely
Make Required Affidavit
Mail or Deliver Report to:
Conservation Division
State Corporation Commission
211 No. Broadway
Wichita, Kansas

15-135-00050-00-00

WELL PLUGGING RECORD

NORTH

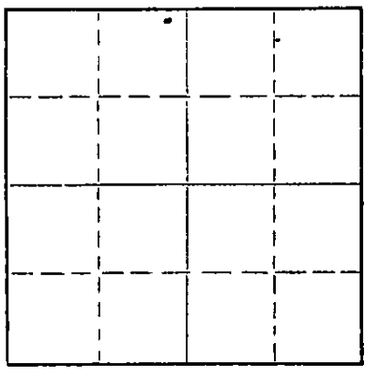

Locate well correctly on above Section Plat

Ness County. Sec. 24 Twp. 19 Rge. (E) 21 (W)

Location as "NE/CNW¼SW¼" or footage from lines NE NE NW

Lease Owner Leben Drilling, Inc.

Lease Name Antenen Well No. 1

Office Address 905 Central Building, Wichita, Kansas

Character of Well (completed as Oil, Gas or Dry Hole) Dry Hole

Date well completed July 8 19 56

Application for plugging filed July 8 19 56

Application for plugging approved July 8 19 56

Plugging commenced July 8 19 56

Plugging completed July 8 19 56

Reason for abandonment of well or producing formation Dry Hole

If a producing well is abandoned, date of last production 19

Was permission obtained from the Conservation Division or its agents before plugging was commenced?

Name of Conservation Agent who supervised plugging of this well R. M. Brundege, Hoisington, Kansas

Producing formation Depth to top Bottom Total Depth of Well 4371 Feet

Show depth and thickness of all water, oil and gas formations.

OIL, GAS OR WATER RECORDS — CASING RECORD

FORMATION	CONTENT	FROM	TO	SIZE	PUT IN	PULLED OUT
				8 5/8"	232'	

Describe in detail the manner in which the well was plugged, indicating where the mud fluid was placed and the method or methods used in introducing it into the hole. If cement or other plugs were used, state the character of same and depth placed, from feet to feet for each plug set.

Plugged at 210' with 1/3 sack of hulls and 20 sacks of cement through drill pipe. Filled hole with heavy mud to 35' and plugged with 1/3 sack of hulls and 10 sacks of cement to surface.

(If additional description is necessary, use BACK of this sheet)

Name of Plugging Contractor Leben Drilling, Inc.

Address 905 Central Building, Wichita, Kansas

STATE OF Kansas, COUNTY OF Sedgwick, ss.

James M. Battin (employee of owner) of the above-described well, being first duly sworn on oath, says: That I have knowledge of the facts, statements, and matters herein contained and the log of the above-described well as filed and that the same are true and correct. So help me God.

(Signature) James M Battin

905 Central Building, Wichita, Ks.
(Address)

SUBSCRIBED AND SWORN TO before me this 10th day of July, 19 56

Paul Konrad
Notary Public.

My commission expires July 10, 1957

PLUGGING
FILE SEC 24 T 19 R 21W
BOOK PAGE 78 LINE 38

07-11-1956

6-44M

15-135-00050-00-00

CONTRACTOR'S WELL LOG

COMPANY: Leben Drilling, Inc. and Bankoff Oil Company
CONTRACTOR: Leben Drilling, Inc.
FARM: Antenen #1
LOCATION: NE NE NW Section 24-19S-21W Ness County, Kansas
COMMENCED: June 25, 1956
COMPLETED: July 8, 1956

0	36	Surface Clay
36	60	Shale, Shell and Sand
60	200	Shale and Shells
200	232	Lime and Shale
232	275	Shale and Shells
275	850	Sahel and Redbed
850	1228	Shale and Lime
1228	1425	Shale and Redbed
1425	1456	Anhydrite
1456	1550	Shale and Shells
1550	1845	Shale and Lime
1845	2035	Shale
2035	2180	Shale and Shells
2180	2220	Lime and Shale
2220	2309	Lime and Shale
2309	2408	Lime
2408	2530	Lime
2530	2592	Sandy Lime
2592	2657	Sandy Lime
2657	2842	Sandy Lime
2842	2990	Shale and Lime
2990	3126	Lime and Shale
3126	3465	Shale and Lime
3465	3544	Lime and Shale
3544	3639	Shale and Lime
3639	3710	Shale and Lime
3710	3762	Shale and Lime
3762	3844	Lime
3844	3897	Lime and Shale
3897	3927	Lime
3927	4014	Lime
4014	4135	Lime and Shale
4135	4186	Lime
4186	4238	Lime and Sahel
4238	4242	Sand
4242	4281	Sand and Shale
4281	4291	Shale and Lime
4291	4329	Conglomerate
4329	4371	Lime
	4371	Rotary Total Depth, D & A

Set 8 5/8" Surface Casing at 232' with 175 sks. regular cement plus 2% Ca. Cl..

I, James M. Battin, do hereby certify that the above and foregoing is a true and correct copy of the log of the Antenen #1, NE NE NW of Section 24-19S-21W, Ness County, Kansas, as reflected by the files of Leben Drilling, Inc..

James M Battin

State of Kansas)
Sedgwick County) ss:

Subscribed and Sworn to before me, a Notary Public, in and for Sedgwick County, Kansas, this 10th day of July, 1956.

Jean Thomas
(Notary Public)

My commission expires July 10, 1957

07-11-1956

PLUGGING
FILE SEC 24 T 19 R 21W
BOOK PAGE 78 LINE 38