

15-135-20582-00-00

STATE OF KANSAS  
STATE CORPORATION COMMISSION


Form CP-4

Give All Information Completely  
Make Required Affidavit  
Mail or Deliver Report to:  
Conservation Division  
State Corporation Commission  
212 No. Market  
Wichita, Kansas 67202

WELL PLUGGING RECORD

Ness County, Sec 21 Twp. 19S Rge. (E) 21 (W)

Location as "NE/CNWxSWx" or footage from lines NW NW SW  
Lease Owner Acme Oil Corp.  
Lease Name Meyer Well No. 2  
Office Address 6235 W. Kellogg - Wichita, Kansas  
Character of Well (completed as Oil, Gas or Dry Hole) dry  
Date well completed 3-15 19 72  
Application for plugging filed 3-15 19 72  
Application for plugging approved 3-15 19 72  
Plugging commenced 9:35 3-15 19 72  
Plugging completed 11:00 PM 3-15 19 72  
Reason for abandonment of well or producing formation

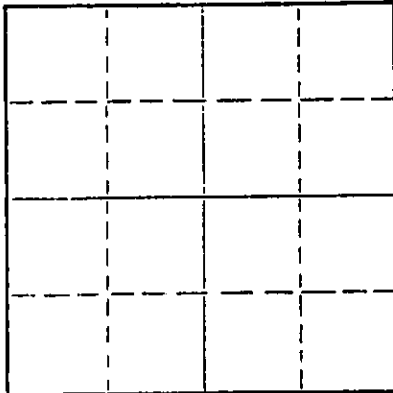

Locate well correctly on above  
Section Plat

If a producing well is abandoned, date of last production none 19  
Was permission obtained from the Conservation Division or its agents before plugging was commenced? yes

Name of Conservation Agent who supervised plugging of this well Leo Massey  
Producing formation Depth to top Bottom Total Depth of Well 4404 Feet  
Show depth and thickness of all water, oil and gas formations.

OIL, GAS OR WATER RECORDS

CASING RECORD

| FORMATION   | CONTENT | FROM | TO  | SIZE  | PUT IN | PULLED OUT |
|-------------|---------|------|-----|-------|--------|------------|
| Soil & Clay | 0       | 0    | 510 | 8 5/8 | 501    | 0          |
|             |         |      |     |       |        |            |
|             |         |      |     |       |        |            |
Describe in detail the manner in which the well was plugged, indicating where the mud fluid was placed and the method or methods used in introducing it into the hole. If cement or other plugs were used, state the character of same and depth placed, from feet to feet for each plug set.

Plugged hole - plug @ 520 - 50 sx @ 40' 10 sx  
2 sx in rat hole.

RECEIVED  
STATE CORPORATION COMMISSION  
MAR 21 1972  
CONSERVATION DIVISION  
Wichita, Kansas

03-21-1972

(If additional description is necessary, use BACK of this sheet)

Name of Plugging Contractor B & B Drilling, Inc.  
Address 720 Union Center - Wichita, Kansas

STATE OF Kansas, COUNTY OF Sedgwick, ss.

Bill Lahar (employee of owner) or (owner or operator) of the above-described well, being first duly sworn on oath, says: That I have knowledge of the facts, statements, and matters herein contained and the log of the above-described well as filed and that the same are true and correct. So help me God.

(Signature) Bill Lahar

720 Union Center - Wichita, Kansas  
(Address)

SUBSCRIBED AND SWORN TO before me this 20th day of March, 19 72

May 31, 1974

Alma A. Neises  
Alma A. Neises

Notary Public.

My commission expires

B & B DRILLING, INC.  
720 Union Center  
Wichita, Kansas 67202

RECEIVED  
STATE CORPORATION COMMISSION  
MAR 21 1972  
CONSERVATION DIVISION  
Wichita, Kansas

March 20, 1972

03-21-1972

DRILLERS LOG

Re: Meyer # 2  
T1W E1W S11 Section 21-19S-21W  
Wess County, Kansas

OPERATOR: Acme Oil Corp.  
CONTRACTOR: B & B Drilling, Inc.  
COMPLETION DATE: March 6, 1972  
CORKED END: March 15, 1972  
TOTAL DEPTH: 4404'


Set 3 5/8" O 501 w/ 250 gr

|      |      |              |
|------|------|--------------|
| 0    | 502  | Surface Hole |
| 502  | 1300 | Shale & Sand |
| 1300 | 1470 | Shale & Sand |
| 1470 | 1502 | Anhydrite    |
| 1502 | 1733 | Shale & Sand |
| 1733 | 2245 | Shale        |
| 2245 | 2445 | Shale & Lime |
| 2445 | 2570 | Shale & Lime |
| 2570 | 3010 | Lime         |
| 3010 | 3125 | Lime         |
| 3125 | 3340 | Shale        |
| 3340 | 3520 | Shale        |
| 3520 | 3365 | Lime & Shale |
| 3365 | 4054 | Lime         |
| 4054 | 4262 | Lime         |
| 4262 | 4320 | Lime         |
| 4320 | 4404 | Lime         |
| 4404 |      | Total Depth  |

DST # 1 3919 - 4005'  
DST # 2 4265 - 4295'  
DST # 3 4320 - 4340'  
DST # 4 4395 - 4404'

D & A

We certify the above and foregoing to be true and correct copy of the log on the # 2 Meyer, located in Wess County, Kansas.

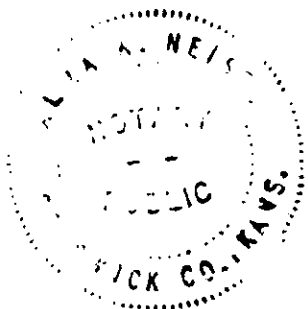

Bill Baker President

Alma Neiser Notary Public  
Subscribed and sworn to before me this  
20th day of March, 1972.  
My commission expires may 31, 1974