

STATE OF KANSAS
STATE CORPORATION COMMISSION

WELL PLUGGING RECORD

Give All Information Completely
Make Required Affidavit
Mail or Deliver Report to
Conservation Division
State Corporation Comm.
245 North Water
Wichita, KS 67202

Ness County, Sec. 26 Twp. 19S Rge. 21W E/W
Location as "NE/CNW $\frac{1}{4}$ SW $\frac{1}{4}$ " or footage from lines
SE NW


Lease Owner PICKRELL DRILLING COMPANY
Lease Name ANTENEN FF Well No. 1
Office Address 205 LITWIN BLDG., WICHITA, KS. 67202
Character of Well (Completed as Oil, Gas or Dry Hole)

Dry Hole
Date Well completed 4-7-77 19
Application for plugging filed 4-7-77 19
Application for plugging approved 4-7-77 19
Plugging commenced 4-7-77 19
Plugging completed 4-7-77 19
Reason for abandonment of well or producing formation
Dry Hole

If a producing well is abandoned, date of last production 19

Was permission obtained from the Conservation Division or its agents before plugging was commenced? Yes

Name of Conservation Agent who supervised plugging of this well Len Massey
Producing formation _____ Depth to top _____ Bottom _____ Total Depth of Well 4420
Show depth and thickness of all water, oil and gas formations.

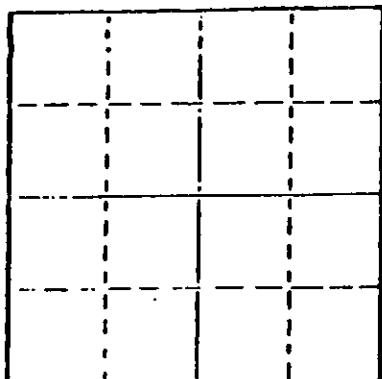

OIL, GAS OR WATER RECORDS

CASING RECORD

FORMATION	CONTENT	FROM	TO	SIZE	PUT IN	PULLED OUT
				8 5/8	230	None

Describe in detail the manner in which the well was plugged, indicating where the mud fluid was placed and the method or methods used in introducing it into the hold. If cement or other plugs were used, state the character of same and depth placed, from _____ feet to _____ feet for each plug set.

50 sacks at 600'
25 sacks at 215'
10 sacks at 40 w/BP
Comp. at 2:30AM 4-7-77

04-22-1977

(If additional description is necessary, use BACK of this sheet)

Name of Plugging Contractor PICKRELL DRILLING COMPANY

STATE OF KANSAS COUNTY OF SEDGWICK, ss.
C. W. SEBITS (employee of owner) or (owner or operator)

of the above-described well, being first duly sworn on oath, says: That I have knowledge of the facts, statements, and matters herein contained and the log of the above-described well as filed and that the same are true and correct. So help me God. BY: C. W. Sebits

(Signature) *C. W. Sebits*
205 LITWIN BLDG., WICHITA, KS. 67202
(Address)

SUBSCRIBED AND SWORN TO before me this 15 day of April, 19 77



Jo Ann Sarver
Jo Ann Sarver Notary Public.

My commission expires _____

15-135-21310-00-00

ROTARY DRILLING LOG

COMPANY: PICKRELL DRILLING COMPANY
205 LITWIN BLDG.,
WICHITA, KS. 67202

Rotary Drilling Commenced 3-29-77

LOCATION: ANTENEN FF #1
SE NW Sec. 26-19S-21W
Ness Co., Ks.

Rotary Drilling Completed 4-07-77

CONTRACTOR: **PICKRELL DRILLING COMPANY**
Wichita, Kansas

CASING RECORD: Surface pipe 8 5/8" set at 230'KB with 150sx. Comp. 3-29-77 @ 4:15PM

LOG

(Figures indicate bottom of formation — measurements from top of rotary bushing.)

Post Rock Shale	235
Cement Shale	1220
Shale & Shells	1527
Anhy.	1558
Shale & Shells	1720
Shale & Shells	1933
Lime & Shale	2262
Lime & Shale	2438
Lime & Shale	2605
Lime	2715
Lime & Shale	2830
Lime & Shale	3033
Lime & Shale	3200
Lime & Shale	3375
Lime & Shale	3539
Lime & Shale	3678
Lime & Shale	3878
Lime & Shale	4012
Lime	4110
Lime & Shale	4210
Lime & Shale	4257
Lime	4334
Lime & Shale	4360
Lime	4420

04-22-1977

The undersigned, C. W. Sebitts, Attorney-in-Fact for PICKRELL DRILLING COMPANY, hereby certifies in behalf of said Company, that the above is a true and correct log of the formation encountered in drilling the above well as reflected by the Daily Drilling Reports.

PICKRELL DRILLING COMPANY

By *C. W. Sebitts*
Attorney-in-Fact
C. W. Sebitts

STATE OF KANSAS }
COUNTY OF SEDGWICK } ss.:

On this 15 day of April, 19 77, before me the undersigned, a Notary Public, in and for

the County and State aforesaid, personally appeared C. W. Sebitts, to me known to be the identical person who subscribed the name of PICKRELL DRILLING COMPANY to the foregoing instrument as its Attorney-in-Fact and acknowledged to me that he executed the same as his free and voluntary act and deed, and as the free and voluntary act and deed of such company, for the uses and purposes therein set forth.

Given under my hand and seal of office the day and year last above written.

My commission expires: 

Jo Ann Sarver
Notary Public
Jo Ann Sarver