

15-135-19135-00-00

STATE OF KANSAS
STATE CORPORATION COMMISSION


WELL PLUGGING RECORD

Give All Information Completely
Make Required Affidavit
Mail or Deliver Report to:
Conservation Division
State Corporation Commission
211 No. Broadway
Wichita, Kansas

Ness County, Sec. 32 Twp. 19 Rge. 21 (E) W (W)

Location as "NE/CNW&SW" or footage from lines. 544' E. & 755' S. of NW Cor.
Lease Owner Cities Service Oil Company
Lease Name Batt "A" Well No. 1
Office Address Box 308, Great Bend, Kansas
Character of Well (completed as Oil, Gas or Dry Hole) Dry Hole
Date well completed January 10 19 64
Application for plugging filed January 10 19 64
Application for plugging approved January 10 19 64
Plugging commenced January 10 19 64
Plugging completed January 10 19 64
Reason for abandonment of well or producing formation Dry Hole

NORTH

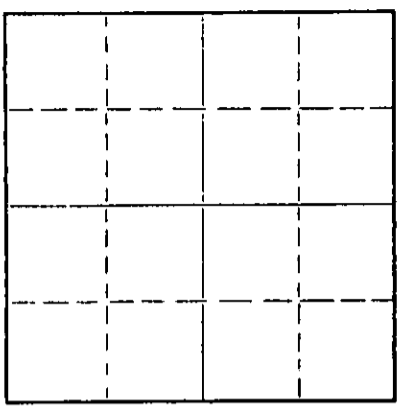

Locate well correctly on above Section Plat

If a producing well is abandoned, date of last production _____ 19____
Was permission obtained from the Conservation Division or its agents before plugging was commenced? Yes

Name of Conservation Agent who supervised plugging of this well Eldon Petty
Producing formation _____ Depth to top _____ Bottom _____ Total Depth of Well 4634 Feet
Show depth and thickness of all water, oil and gas formations.

OIL, GAS OR WATER RECORDS

CASING RECORD

FORMATION	CONTENT	FROM	TO	SIZE	PUT IN	PULLED OUT
				8-5/8"	520'	None

Describe in detail the manner in which the well was plugged, indicating where the mud fluid was placed and the method or methods used in introducing it into the hole. If cement or other plugs were used, state the character of same and depth placed, from _____ feet to _____ feet for each plug set.

4634-515' heavy mud.
515-455' Halliburton plug and 20 sacks cement.
455-240' heavy mud.
240-180' Halliburton plug and 20 sacks cement.
180- 40' heavy mud.
40' to base of cellar, 10 sacks cement with Halliburton plug.

RECEIVED
STATE CORPORATION COMMISSION

JAN 28 1964
01-28-1964
CONSERVATION DIVISION
Wichita, Kansas

(If additional description is necessary, use BACK of this sheet)

Name of Plugging Contractor Peel Brothers, Inc.
Address Box 359, Hoisington, Kansas

STATE OF Kansas, COUNTY OF Barton, ss.
John D. Forsyth (employee of owner) of the above-described well, being first duly sworn on oath, says: That I have knowledge of the facts, statements, and matters herein contained and the log of the above-described well as filed and that the same are true and correct. So help me God.

(Signature) John D Forsyth
Box 308, Great Bend, Kansas
(Address)

SUBSCRIBED AND SWORN TO before me this 21st day of January 19 64

My commission expires December 6, 1966 Chas McJannet Notary Public.



WELL RECORD

15-135-19135-00-00

WILDCAT _____
 DISCOVERY _____
 POOL _____

Company Cities Service Oil Company Well No. 1 Farm Batt #A#
 Location 544' E. & 755' S. of NW Corner Sec. 32 T. 19S R. 21W
 Elev. Serv. K.B. 2276' D. F. 2273' Gr. 2268' Co. Ness State Kansas
 N. I. P. Dry Hole A. I. P. _____ Grav. _____

Pay Zones _____

Perforations _____

Acid None Hydrafrac _____

T. D. 4634' P. B. T. D. _____ N. T. D. _____ Drlg. Comm. 12-21-63 Drlg. Comp. 1-9-64

CASING RECORD:

8 5/8" @ 531' w/300 sax. cem.

Formation Records:

Formation	Depth
clay & shale	0 - 161
shale	915
sand & shale	1260
shale	1590
anhydrite	1627
shale	2230
lime & shale	2520
lime	2860
lime & shale	3505
lime	3605

R.T.D. 3605' = 3505' Pipe Strap

Corr: anhydrite 1490-1527'

Log Continued:

lime	3505 - 3705
lime & shale	3780
lime	4146
lime & shale	4285
lime	4430
lime & chert	4461
chert	4506
chert, lime & shale	4541
lime, shale & chert	4580
lime & chert	4610
lime	4634
Rotary Total Depth	4634

Contractor Peel Bros. Inc.

Heebner	3754' (-1478)
Toronto	3771' (-1495)
Lansing	3801' (-1525)
Base Kansas City	4135' (-1859)
Fort Scott	4310' (-2034)
Cherokee Shale	4330' (-2054)
Conglomerate	4380' (-2104)
Mississippi	4410' (-2134)
Kinderhook Lime	4522' (-2246)
Viola	4604' (-2328)
Penetration	30'
Log Total Depth	4634'

Styo

1000'	■
1500'	■
2000'	■
2500'	■
3000'	■
3500'	■
4000'	■

RECEIVED
 STATE CORPORATION COMMISSION

JAN 28 1964
 01-28-1964
 CONSERVATION DIVISION
 Wichita, Kansas