


STATE OF KANSAS  
STATE CORPORATION COMMISSION

Give All Information Completely  
Make Required Affidavit  
Mail or Deliver Report to:  
Conservation Division  
State Corporation Commission  
800 Biting Building  
Wichita, Kansas

15-135-00088-00-00

WELL PLUGGING RECORD

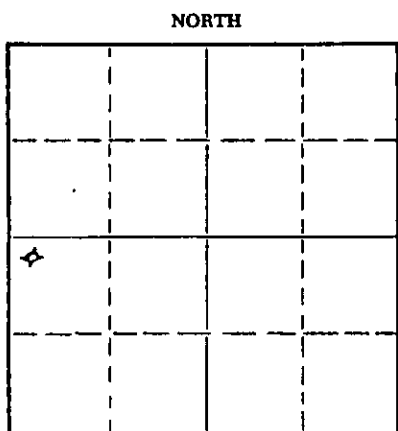

Locate well correctly on above Section Plat

Ness County, Sec 34 Twp 19S Rge. (E) 21 (W)  
Location as "NE/CNW/SW" or footage from lines NW NW SW  
Lease Owner Aurora Gasoline Company  
Lease Name Moore Well No. 1  
Office Address Roberts Hotel, Pratt, Kansas  
Character of Well (completed as Oil, Gas or Dry Hole) Dry  
Date well completed 1956  
Application for plugging filed January 27 1956  
Application for plugging approved January 27 1956  
Plugging commenced January 28 1956  
Plugging completed February 4 1956  
Reason for abandonment of well or producing formation Dry - Non-commercial  
If a producing well is abandoned, date of last production 1956  
Was permission obtained from the Conservation Division or its agents before plugging was commenced? Yes

Name of Conservation Agent who supervised plugging of this well Mr. Brundage  
Producing formation \_\_\_\_\_ Depth to top \_\_\_\_\_ Bottom \_\_\_\_\_ Total Depth of Well 4410 Feet  
Show depth and thickness of all water, oil and gas formations.

OIL, GAS OR WATER RECORDS

CASING RECORD

FORMATION	CONTENT	FROM	TO	SIZE	PUT IN	PULLED OUT
				8-5/8"	154'	None
				5-1/2"	4440'	3510'

Describe in detail the manner in which the well was plugged, indicating where the mud fluid was placed and the method or methods used in introducing it into the hole. If cement or other plugs were used, state the character of same and depth placed, from \_\_\_\_\_ feet to \_\_\_\_\_ feet for each plug set.

Perforations plugged with sand - brought to height of 4410'.  
Dumped 5 sacks cement on top of sand. Pumped 200 sacks through plugging container.

02-08-1956

(If additional description is necessary, use BACK of this sheet)  
Name of Plugging Contractor West Supply Company  
Address Chase, Kansas

STATE OF Kansas, COUNTY OF Sedgwick, ss.  
Leonard Olds (employee of owner) or (owner or operator) of the above-described well, being first duly sworn on oath, says: That I have knowledge of the facts, statements, and matters herein contained and the log of the above-described well as filed and that the same are true and correct. So help me God.

(Signature) Leonard Olds  
Leonard Olds  
Roberts Hotel, Pratt, Kansas  
(Address)

SUBSCRIBED AND SWORN TO before me this 6th day of February, 1956

My commission expires March 24, 1959

Agnes M. Quinn  
Notary Public.

AGNES M. QUINN

PLUGGING  
FILE SEC 34 T 19 R 21 W  
BOOK PAGE 34 LINE 33

WELL LOG.

WELCH & OLSSON DRILLING COMPANY, INC.  
CONTRACTOR:  
WELCH & OLSSON DRILLING COMPANY, INC.

Elevation: 2275'  
Comm. Drlg: 11-26-55  
Comp. Drlg: 12-9-55  
Production: Oil Well

MOORE #1:  
NW NW SW 34-19-21W,  
Ness County, Kansas.

Casing Record.

Set 154' of 8 5/8 with 150 sacks of cement.

(Figures indicated bottom of formations.)

<u>FORMATION</u>	<u>DEPTH</u>	<u>FORMATION TOP.</u>
Shale:	370	Neobner: 3782 (-1907)
Shale & Red Bed:	410	Toronto: 3799 (-1524)
Red Bed & Shale:	590	Lansing-Kansas City: 3829 (-1554)
Sand:	600	Base Kansas City: 4158 (-1883)
Shale & Shells:	800	Ft. Scott Limestone: 4324 (-2049)
Shale & Sand:	1180	Cherokee Shale: 4339 (-2064)
Shale & Shells:	1495	Mississippian: 4485 (-2130)
Anhydrite:	1525	
Shale & Shells:	2195	
Shale w/Lime Strks:	2380	
Shale & Lime:	2490	
Lime & Shale:	2935	
Shale w/Lime Strks:	3075	
Lime & Shale:	3210	
Shale & Lime:	3310	
Shale & Shells:	3460	
Shale & Lime:	3561	
Lime & Shale:	3835	
Lime:	4165	
Cherty Lime & Shale:	4210	
Lime:	4295	
Lime & Shale:	4330	
Lime-Shale & Chert:	4351	
Lime:	4390	
Lime & Shale:	4394	
Lime:	4420 T. D.	

STATE OF KANSAS, )  
                          ) SS:  
SEDGWICK COUNTY, )

I hereby certify that the above is a true and correct copy of Drillers Log of well drilled in the NW NW SW of Section 34, Township 19, Range 21 West, Ness County, Kansas.

WELCH & OLSSON DRILLING COMPANY, INC.

BY

  
R. E. WELCH

Subscribed and sworn to before me this 15th day of December, 1955.

  
Notary Public.

My commission expires:  
June 12, 1959