


Give All Information Completely  
Make Required Affidavit  
Mail or Deliver Report to:  
Conservation Division  
State Corporation Commission  
211 No. Broadway  
Wichita, Kansas

WELL PLUGGING RECORD

Ness County, Sec. 34 Twp. 19S Rge. 21W (E) (W)

Location as "NE/CNW/SE/SW" or footage from lines C NW NW  
Lease Owner Kern-Landes Exploration Co., Inc.  
Lease Name Moore Well No. 1  
Office Address P. O. Box 699, Magnolia, Arkansas  
Character of Well (completed as Oil, Gas or Dry Hole) Dry Hole  
Date well completed November 2 19 62  
Application for plugging filed November 2 19 62  
Application for plugging approved November 2 19 62  
Plugging commenced November 2 19 62  
Plugging completed November 2 19 62  
Reason for abandonment of well or producing formation Dry Hole

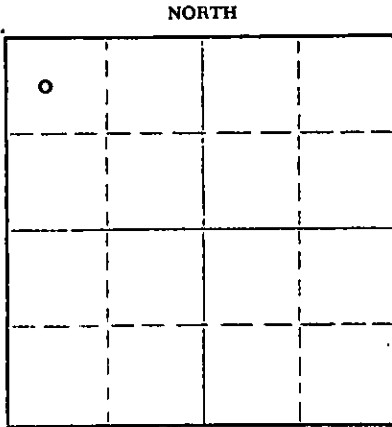

Locate well correctly on above Section Plat

If a producing well is abandoned, date of last production \_\_\_\_\_ 19\_\_\_\_  
Was permission obtained from the Conservation Division or its agents before plugging was commenced? Yes

Name of Conservation Agent who supervised plugging of this well Eldon Petty, Box 326, Hays, Kansas  
Producing formation \_\_\_\_\_ Depth to top \_\_\_\_\_ Bottom \_\_\_\_\_ Total Depth of Well 4545 Feet  
Show depth and thickness of all water, oil and gas formations.

OIL, GAS OR WATER RECORDS				CASING RECORD		
FORMATION	CONTENT	FROM	TO	SIZE	PUT IN	PULLED OUT
		0	408'	8 5/8"	408'	None

Describe in detail the manner in which the well was plugged, indicating where the mud fluid was placed and the method or methods used in introducing it into the hole. If cement or other plugs were used, state the character of same and depth placed, from \_\_\_\_\_ feet to \_\_\_\_\_ feet for each plug set.

Set Plug @ 400' 25 sacks cement & 1/2 sack hulls  
Plug @ 40' 10 sacks cement & 1/2 sack hulls

11-14-1962  
CONSERVATION DIVISION  
WICHITA, KANSAS

(If additional description is necessary, use BACK of this sheet)  
Name of Plugging Contractor Hellar Drilling Company, Inc.  
Address 1014 Union Center, Wichita, 2, Kansas

STATE OF Kansas, COUNTY OF Sedgwick, ss.  
D. L. Hellar, Pres. of Hellar Drilg. Co., Inc. (employee of owner) or (owner or operator) of the above-described well, being first duly sworn on oath, says: That I have knowledge of the facts, statements, and matters herein contained and the log of the above-described well as filed and that the same are true and correct. So help me God.

(Signature) D. L. Hellar  
D. L. Hellar - President  
1014 Union Center, Wichita 2, Kansas  
(Address)

SUBSCRIBED AND SWORN TO before me this 13th day of November, 19 62

My commission expires March 25, 1964.  
Catherine Darcey - Notary Public.

15-135-00656-00-00

DRILLER'S LOG

OWNER:  
CONTRACTOR:  
LEASE:  
LOCATION:  
  
COMMENCED:  
COMPLETED:  
CASING:

Kern-Landes Exploration Co. Inc.  
Hellar Drilling Company, Inc.  
#1 Moore  
c NW NW Sec. 34-19S-21W  
Ness County, Kansas  
October 19, 1962  
November 2, 1962  
Set 8 5/8" surface casing @ 408'  
/240 sacks cement.

0- 306	Sand and Red Beds
306- 408	Shale
408-1483	Sand and shale
1483-1494	Shale and Red Bed
1494-1526	Anhydrite
1526-2350	Shale and Red Bed
2350-2472	Sale-Shale & Lime
2472-2578	Ft. Riley
2578-2674	Shale & Lime
2674-2743	Lime
2743-2984	Shale and Lime
2984-3098	Lime and Shale
3098-3430	Shale and Lime
3430-3840	Lime and Shale
3840-3906	Lime
3906-3956	Lansing-K.C.
3956-4022	Lime and Shale
4022-4205	Lime
4205-4271	Lime and shale stks.
4271-4293	Lime
4293-4339	Lime and Shale
4339-4368	Core #1
4368-4410	Lime
4410-4430	Core #2
4430-4439	Core #3
4439-4451	Chert and Lime
4451-4545	Lime and Chert
4545	Rotary Total Depth
	D & A

**RECEIVED**  
STATE CORPORATION COMMISSION  
NOV 11 1962  
CONSERVATION DIVISION  
Topeka, Kansas  
11-14-1962

STATE OF KANSAS )  
                          )    SS  
COUNTY OF SEDGWICK )

I, D. L. Hellar, do hereby certify that the above and foregoing is a true and correct copy of the log of the #1 Moore, located in the c NW NW of Section 34-19S-21W, Ness County, Kansas, as reflected by the files of the Hellar Drilling Company, Inc.

HELLAR DRILLING COMPANY, INC.

By: D. L. Hellar  
D. L. Hellar, President

Subscribed and sworn to before me, a Notary Public, in and for Sedgwick County, Kansas, this 13th day of November, 1962.

Catherine Darcey  
Notary Public - Catherine Darcey

My Commission Expires:  
March 25, 1964.