


Give All Information Completely
Make Required Affidavit
Mail or Deliver Report to:
Conservation Division
State Corporation Commission
211 No. Broadway
Wichita, Kansas

WELL PLUGGING RECORD

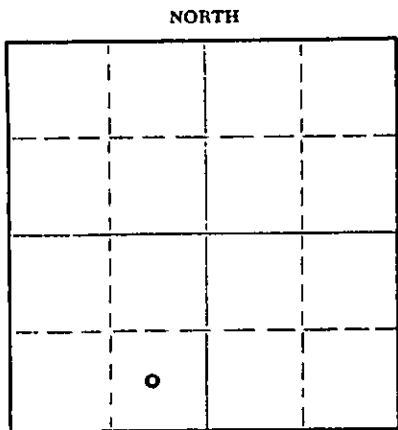

Locate well correctly on above
Section Plat

Ness County. Sec. 34 Twp. 19S Rge. 21W (E)____(W)
Location as "NE/CNW/SW" or footage from lines C SE SW
Lease Owner Kern-Landes Exploration Co., Inc.
Lease Name Moore Well No. A-1
Office Address PO Box 699, Magnolia, Arkansas
Character of Well (completed as Oil, Gas or Dry Hole) Dry Hole
Date well completed March 31 19 63
Application for plugging filed March 31 19 63
Application for plugging approved March 31 19 63
Plugging commenced March 31 19 63
Plugging completed March 31 19 63
Reason for abandonment of well or producing formation Dry Hole

If a producing well is abandoned, date of last production _____ 19____
Was permission obtained from the Conservation Division or its agents before plugging was commenced? Yes

Name of Conservation Agent who supervised plugging of this well Eldon Petty 326, Hays, Kansas
Producing formation _____ Depth to top _____ Bottom _____ Total Depth of Well 4510 Feet
Show depth and thickness of all water, oil and gas formations.

OIL, GAS OR WATER RECORDS

CASING RECORD

FORMATION	CONTENT	FROM	TO	SIZE	PUT IN	PULLED OUT
		0	428'	8 5/8"	428'	none

Describe in detail the manner in which the well was plugged, indicating where the mud fluid was placed and the method or methods used in introducing it into the hole. If cement or other plugs were used, state the character of same and depth placed, from _____ feet to _____ feet for each plug set.

Set Plug @ 400' 25 sacks cement &
Plug @ 40' 10 sacks cement

RECEIVED
STATE CORPORATION COMMISSION
APR 8 1963
04-08-1963
CONSERVATION DIVISION
Wichita, Kansas

(If additional description is necessary, use BACK of this sheet)
Name of Plugging Contractor Hellar Drilling Company, Inc.
Address 1014 Union Center, Wichita 2, Kansas

STATE OF Kansas COUNTY OF Sedgwick, ss.
D. L. Hellar, Pres. of Hellar Drilg. Co., Inc. (employee of owner) or (owner or operator) of the above-described well, being first duly sworn on oath, says: That I have knowledge of the facts, statements, and matters herein contained and the log of the above-described well as filed and that the same are true and correct. So help me God.

(Signature) D. L. Hellar D. L. Hellar, President
1014 Union Center, Wichita 2, Kansas
(Address)

SUBSCRIBED AND SWORN TO before me this 5th day of April, 19 63

March 25, 1964

My commission expires _____

Catherine Darcey
Catherine Darcey Notary Public.

DRILLER'S LOG

COMPANY: Kern-Landes Exploration Co. Inc.
CONTRACTOR: Hellar Drilling Company, Inc.
LEASE: #A-1 Moore
LOCATION: c SE SW 34-19S-21W
Ness County, Kansas
COMMENCED: March 20, 1963
COMPLETED: March 31, 1963
CASING: Set 8 5/8" surface casing @428'/240 sacks

0-428	Sand and shale
428-822	Shale, sand and Red Bed
822-833	Blaine Anhydrite
833-910	Red Bed
910-1115	Sand
1115-1325	Shale & sand stks.
1325-1493	Shale, sand & Red Bed
1493-1525	Cinn.-Anhydrite
1525-1730	Shale-shells
1730-2080	Shale, Red Bed & Salt Section
2080-2325	Shale & Lime
2325-2428	Lime
2428-2642	Lime & Shale
2642-2717	Lime
2717-3855	Lime & Shale
3855-3975	Lime
3975-4017	Lansing-K.C.
4017-4173	Lime
4173-4357	Lime & Shale
4357-4382	Core #1
4382-4445	Lime & Shale
4445-4446	Lime
4446-4476	Core #2
4476-4510	Mississippi Lime
4510	Rotary Total Depth--Ran Electric Log Dry & Abandoned

RECEIVED
STATE OF KANSAS
APR 8 1963
CONSERVATION DIVISION
Wichita, Kansas
04-08-1963

STATE OF KANSAS)
COUNTY OF SEDGWICK) SS

I, D. L. Hellar, do hereby certify that the above and foregoing is a true and correct copy of the log of the #A-1 Moore, located in c SE SW Section 34-19S-21W, Ness County, Kansas, as reflected by the files of the Hellar Drilling Company, Inc.

HELLAR DRILLING COMPANY, INC.

By D. L. Hellar
President - D. L. Hellar

Subscribed and sworn to before me, a Notary Public, in and for Sedgwick County, Kansas, this 5th day of April, 1963.

Catherine Darcey
Notary Public - Catherine Darcey

My Commission Expires:
March 25, 1964.