

STATE CORPORATION COMMISSION OF KANSAS
OIL & GAS CONSERVATION DIVISION

WELL COMPLETION OR RECOMPLETION FORM
ACO-1 WELL HISTORY

DESCRIPTION OF WELL AND LEASE

Operator: License # 5171
Name TXO PRODUCTION CORP.
Address 155 N. Market
Suite 1000
City/State/Zip Wichita, KS 67202

Operator Contact Person Jerry W. Collins
Phone (316) 269-7661

Contractor: License # 6033
Name Murfin Drilling Co.

Wellsite Geologist William J. Stobbe
Phone

PURCHASER N/A

Designate Type of Completion

- New Well Re-Entry Workover
- OH SWD Temp Abd
- Gas Inj Delayed Comp.
- Dry Other (Core, Water Supply etc.)

If OWWO: old well info as follows:

Operator N/A
Well Name N/A
Comp. Date N/A Old Total Depth

WELL HISTORY

Drilling Method:

- Mud Rotary Air Rotary Cable

1-31-86 2-5-86 2-7-86
Spud Date Date Reached TD Completion Date

4450' N/A
Total Depth PBD

Amount of Surface Pipe Set and Cemented at 8 5/8 @ 348' feet

Multiple Stage Cementing Collar Used? Yes No
If yes, show depth set feet

If alternate 2 completion, cement circulated from feet depth to w/ SX cmt

API No. 15-135-23,003-0000

County Ness County, KS

E/2 SW SE Sec. 33 Twp. 19 Rge. 23 East West

660 Ft North from Southeast Corner of Section
1650 Ft West from Southeast Corner of Section
(Note: Locate well in section plat below)


Lease Name Crosswhite Well # 1

Field Name Franklin Ext.

Producing Formation "Dry"

Elevation: Ground 2259' KB 2264'

Section Plat

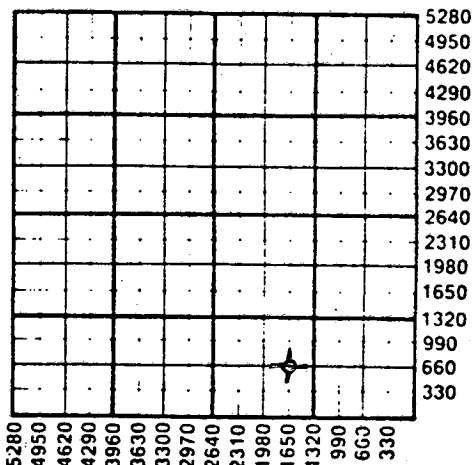

WATER SUPPLY INFORMATION

Source of Water:
Division of Water Resources Permit # N/A

Groundwater N/A Ft North from Southeast Corner
(Well) Ft West from Southeast Corner of
Sec Twp Rge East West

Surface Water Ft North from Southeast Corner
(Stream, pond etc) Ft West from Southeast Corner
Sec Twp Rge East West

Other (explain) N/A
(purchased from city, R.W.D.#)

Disposition of Produced Water: Disposal Repressuring

Docket # N/A

INSTRUCTIONS: This form shall be completed in duplicate and filed with the Kansas Corporation Commission, 200 Colorado Derby Building, Wichita, Kansas 67202, within 90 days after completion or recompletion of any well. Rule 82-3-130 and 82-3-107 apply.

Information on side two of this form will be held confidential for a period of 12 months if requested in writing and submitted with the form. See rule 82-3-107 for confidentiality in excess of 12 months. One copy of all wireline logs and drillers time log shall be attached with this form. Submit CP-4 form with all plugged wells. Submit CP-111 form with all temporarily abandoned wells.

All requirements of the statutes, rules and regulations promulgated to regulate the oil and gas industry have been fully complied with and the statements herein are complete and correct to the best of my knowledge.

Signature Bill Coffey
Title District Geologist Date 2-10-86

Subscribed and sworn to before me this 10 day of February 1986

Notary Public Stephanie R. Stuber
Date Commission Expires 8-31-88



K.C.C. OFFICE USE ONLY
 Letter of Confidentiality Attached
 Wireline Log Received
 Drillers Timelog Received
Distribution
 KCC SWD/Rep NGPA
 KGS Plug Other
(Specify)

Operator Name TXO Production... Lease Name Crosswhite... Well# 1... SEC. 33... TWP. 19S... RGE. 23... East West

WELL LOG

INSTRUCTIONS: Show important tops and base of formations penetrated. Detail all cores. Report all drill stem tests giving interval tested, time tool open and closed, flowing and shut-in pressures, whether shut-in pressure reached static level, hydrostatic pressures, bottom hole temperature, fluid recovery, and flow rates if gas to surface during test. Attach extra sheet if more space is needed. Attach copy of log.

Drill Stem Tests Taken Yes No
 Samples Sent to Geological Survey Yes No
 Cores Taken Yes No

Formation Description
 Log Sample

DST #1, 4245-4300' (Ft. Scott)
 IFP/30"=50-50#, weak blow
 ISIP/60"=1174#
 FFP/45"=60-60#, very weak blow
 FSIP/90"=1103#
 Rec. 60' SGCDM

Name	Top	Bottom
Heebner	3713	-1449'
Lansing	3762	-1498'
Iola	3929	-1665'
Drum	3955	-1691'
Dennis	3992	-1728'
BKC	4077	-1813'
Pawnee	4194	-1930'
Ft. Scott	4272	-2008'
Cherokee Sh.	4295	-2031'
Mississippi	4393	-2129'
LTD	4451'	
RTD	4450'	

CASING RECORD <input type="checkbox"/> New <input type="checkbox"/> Used							
Report all strings set-conductor, surface, intermediate, production, etc.							
Purpose of String	Size Hole Drilled	Size Casing Set (In O.D.)	Weight Lbs/Ft.	Setting Depth	Type of Cement	#Sacks Used	Type and Percent Additives
Surface	12-1/4"	8-5/8"	20#	348'	Lite Class A	125 75	2% gel 3% CaCl
PERFORATION RECORD				Acid, Fracture, Shot, Cement Squeeze Record			
Shots Per Foot	Specify Footage of Each Interval Perforated			(Amount and Kind of Material Used)		Depth	
TUBING RECORD <input checked="" type="checkbox"/> N/A				Liner Run <input type="checkbox"/> Yes <input type="checkbox"/> No			
Date of First Production	Producing Method						
N/A (Dry)	<input type="checkbox"/> Flowing <input type="checkbox"/> Pumping <input type="checkbox"/> Gas Lift <input type="checkbox"/> Other (explain).....						
Estimated Production Per 24 Hours	Oil	Gas	Water	Gas-Oil Ratio		Gravity	
	0 Bbls	0 MCF	0 Bbls				

METHOD OF COMPLETION

Production Interval

Disposition of gas: Vented Open Hole Perforation
 Sold Other (Specify)
 Used on Lease

'D & A' 2-7-86

Dually Completed
 Commingled