


15-135-21036-0000

STATE OF KANSAS
STATE CORPORATION COMMISSION
CONSERVATION DIVISION
P. O. BOX 17027
WICHITA, KANSAS 67217

FORM CP-4

WELL PLUGGING RECORD

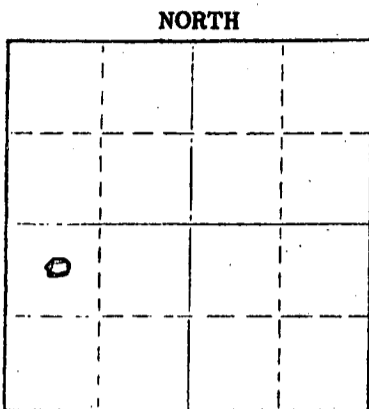

Locate well correctly on above Section Plot

Ness County, Sec. 2 Twp. 19 Rge. 24 (W)
Location as "NE/CNW/SE" or footage from lines Cen NW SW
Lease Owner Kaiser-Francis Oil & Gas
Lease Name McDonald Well No. 1
Office Address 4120 East 51st St., Tulsa, Oklahoma 74135
Character of Well (completed as Oil, Gas or Dry Hole) Dry Hole
Date well completed April 24 19 75
Application for plugging filed April 30 19 75
Application for plugging approved 19
Plugging commenced April 24 19 75
Plugging completed April 24 19 75
Reason for abandonment of well or producing formation Dry hole
If a producing well is abandoned, date of last production NA 19
Was permission obtained from the Conservation Division or its agents before plugging was commenced?

Name of Conservation Agent who supervised plugging of this well
Producing formation _____ Depth to top _____ Bottom _____ Total Depth of Well 4345 Feet
Show depth and thickness of all water, oil and gas formations.

OIL, GAS OR WATER RECORDS

CASING RECORD

FORMATION	CONTENT	FROM	TO	SIZE	PUT IN	PULLED OUT
				8 5/8"	266	None

Describe in detail the manner in which the well was plugged, indicating where the mud fluid was placed and the method or methods used in introducing it into the hole. If cement or other plugs were used, state the character of same and depth placed, from _____ feet to _____ feet for each plug set.

Plugged at 600' with 70 sacks of 50-50 pazmix & 6% gel;
plugged at 240' with 20 sacks 50-50 pazmix and 6% gel;
plugged at 40' with 10 sacks of 50-50 pazmix & 6% gel.

RECEIVED
OF THE CORPORATION COMMISSION

MAY 23 1975

(If additional description is necessary, use BACK of this sheet)
Name of Plugging Contractor Strate Drilling Company
Address P. O. Box 355, Great Bend, Kansas 67530

STATE OF Oklahoma COUNTY OF Tulsa

Harry L. Berry (employee of owner) or (owner/lessor) of the above-described

well, being first duly sworn on oath, says: That I have knowledge of the facts, statements, and matters herein contained and the log of the above-described well as filed and that the same are true and correct. So help me God.

(Signature) Harry L. Berry
4120 East 51st St., Tulsa, Okla. 74135
(Address)



SUBSCRIBED AND SWORN TO before me this 21st day of May 19 75
June 12, 1976
(G. A. Weber) Notary Public.

D R I L L E R S L O G

#1 McDonald

CASING RECORD: 260.64' of used 8-5/8" surface casing.	COMPANY: Kaiser-Francis Oil & Gas	DESCRIPTION: C/NW SW Section 2-19S-24W Ness County, Kansas
TOTAL DEPTH: 4345'	CONTRACTOR: Strata Drilling Company	ELEVATION: 2302' GR
	COMMENCED: April 15, 1975	
	COMPLETED: April 24, 1975	

D. & A.

<u>FORMATION</u>	<u>FROM</u>	<u>TO</u>	<u>REMARKS</u>
Shale	0	280	Ran 260.64' of used 8-5/8" surface casing; set and cemented at 266' with 190 sacks of common cement, 2% gel and 3% C. C. Plug down at 2:00 A. M. April 16, 1975.
Shale	280	740	
Shale	740	1560	
Anhydrite	1560	1580	
Shale	1580	2170	
Shale & Lime	2170	2450	
Lime	2450	2605	
Lime & Shale	2605	3885	
Lime	3885	3950	
Lime & Shale	3950	4245	
Lime	4245	4325	
Lime & Chert	4325	4345	

ROTARY TOTAL DEPTH: 4345'

RECEIVED
STATE CORPORATION COMMISSION
MAY 12 1975
CONSERVATION DIVISION
Wichita, Kansas

Ran Electric Log.

D. & A.

Plugged as follows: Plugged at 600' with 70 sacks of 50-50 pozmix & 6% gel; plugged at 240' with 20 sacks of 50-50 pozmix and 6% gel; plugged at 40' with 10 sacks of 50-50 pozmix & 6% gel. Plug down at 3:30 A. M. April 24, 1975.

STATE OF KANSAS)
) ss.
COUNTY OF BARTON)

I certify that this is a true and correct copy of the above log to the best of my knowledge.

STRATA DRILLING COMPANY

Kenneth J. Link
Kenneth J. Link, President

Subscribed and sworn to before me this 30th day of April, 1975.

My Commission Expires:

December 14, 1977

Elaine H. Taylor
Elaine H. Taylor, Notary Public

