


15-135-20790-0000

STATE OF KANSAS
STATE CORPORATION COMMISSION

Form CP-4

Give All Information Completely
Make Required Affidavit
Mail or Deliver Report to:
Conservation Division
State Corporation Commission
P. O. Box 17027
Wichita, Kansas 67217
NORTH

WELL PLUGGING RECORD

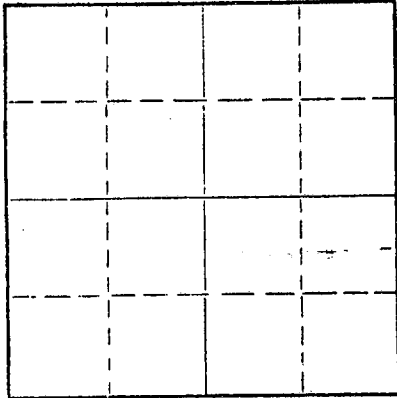

Locate well correctly on above
Section Plat

Ness County. Sec. 2 Twp. 19S Rge. 24W (E) (W)
Location as "NE/CNW/SW" or footage from lines C NE NW
Lease Owner Donald C. Slawson
Lease Name Brandt 'C' Well No. 1
Office Address 408 One Twenty Building, Wichita, Kansas 67202
Character of Well (completed as Oil, Gas or Dry Hole) D & A
Date well completed September 13, 19 73
Application for plugging filed September 13, 19 73
Application for plugging approved September 13, 19 73
Plugging commenced September 13, 19 73
Plugging completed September 13, 19 73
Reason for abandonment of well or producing formation

If a producing well is abandoned, date of last production 19
Was permission obtained from the Conservation Division or its agents before plugging was commenced? Yes

Name of Conservation Agent who supervised plugging of this well Leo Massey, P.O. Box 582, Hays, Kansas 67601
Producing formation Depth to top Bottom Total Depth of Well 4430 Feet
Show depth and thickness of all water, oil and gas formations.

OIL, GAS OR WATER RECORDS

CASING RECORD

FORMATION	CONTENT	FROM	TO	SIZE	PUT IN	PULLED OUT
	Surface			8 5/8"	275 feet	

Describe in detail the manner in which the well was plugged, indicating where the mud fluid was placed and the method or methods used in introducing it into the hole. If cement or other plugs were used, state the character of same and depth placed, from feet to feet for each plug set.

1st plug set @ 600' w/70 sx
2nd plug set @ 240' w/20 sx
3rd plug set @ 40' w/10 sx

RECEIVED
STATE CORPORATION COMMISSION
SEP 21 1973
CONSERVATION DIVISION
Wichita, Kansas

Name of Plugging Contractor Slawson Drilling Company, Inc.
Address 408 One Twenty Building, Wichita, Kansas 67202

STATE OF Kansas, COUNTY OF Sedgwick, ss.
JAMES C. REMSBERG (employee of owner) or (other person) of the above-described well, being first duly sworn on oath, says: That I have knowledge of the facts, statements, and matters herein contained and the log of the above-described well as filed and that the same are true and correct. So help me God.

(Signature) James C. Remsberg
James C. Remsberg
408 One Twenty Building, Wichita, Kansas 67202
(Address)

SUBSCRIBED AND SWORN TO before me this 18th day of September, 19 73

DOLORES B. COADY
STATE NOTARY PUBLIC
SEDGWICK COUNTY, KANSAS
Comm. Expires Mar. 7, 1976

Dolores B. Coady
Notary Public.

WELL LOG

RECEIVED
STATE CORPORATION COMMISSION

SEP 21 1973

CONSERVATION DIVISION
Wichita, Kansas

COMPANY: Donald C. Slawson
408 One Twenty Building
Wichita, Kansas 67202

LEASE: Brandt 'C' #1
C NE NW Sec. 2-19S-24W
Ness County, Kansas

TOTAL DEPTH: 4430 feet

CONTRACTOR: Slawson Drilling Company, Inc.

COMMENCED: September 4, 1973

COMPLETED: September 13, 1973

CASING: 275 feet of 8 5/8"

0-55	Surface Hole
55-280	Gray Shale
280-1557	Shale & Shells
1557-1597	Anhydrite
1597-2239	Shale & Shells
2239-3458	Lime & Shale
3458-3693	Lime
3693-3925	Lime & Shale
3925-4145	Lime
4145-4239	Lime & Shale
4239-4277	Lime
4277-4335	Lime & Shale
4335-4351	Lime
4351-4430	Miss
4430	RTD

STATE OF KANSAS)
) SS.
COUNTY OF SEDGWICK)

I, JAMES C. REMSBERG, of the Slawson Drilling Company, Inc., upon oath state that the above and foregoing is a true and correct copy of the log of the Brandt 'C' #1 well.

James C. Remsberg
JAMES C. REMSBERG

Subscribed and sworn to before me this 18th day of September, 1973.

Dolores B. Coady
Dolores B. Coady

My Commission Expires:

DOLCRES B. COADY
STATE NOTARY PUBLIC
SEDGWICK COUNTY, KANSAS
Comm. Expires Mar. 7, 1976
