

STATE OF KANSAS  
STATE CORPORATION COMMISSION

Give All Information Completely  
Make Required Affidavit  
Mail or Deliver Report to:  
Conservation Division  
State Corporation Commission  
211 No. Broadway  
Wichita, Kansas

WELL PLUGGING RECORD

Ellis County, Sec. 34 Twp. 11 Rge. (E) 19 (W)

Location as "NE/CNW%SW%" or footage from lines NE NE SW

Lease Owner Rains & Williamson Oil Co.

Lease Name JENSEN Well No. 1

Office Address 1425 Wichita Plaza, Wichita, Kansas, 67202

Character of Well (completed as Oil, Gas or Dry Hole) Dry

Date well completed December 20, 19 65

Application for plugging filed verbally - December 19, 19 65

Application for plugging approved verbally - December 19, 19 65


Plugging commenced December 19, 19 65

Plugging completed 5 A. M. December 20, 19 65

Reason for abandonment of well or producing formation D & A

If a producing well is abandoned, date of last production 19

Was permission obtained from the Conservation Division or its agents before plugging was commenced? verbally - yes.

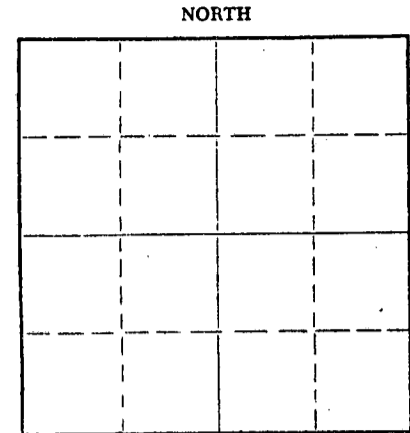

Locate well correctly on above Section Plat

Name of Conservation Agent who supervised plugging of this well Gilbert Leiker

Producing formation Depth to top Bottom Total Depth of Well 3650 Feet

Show depth and thickness of all water, oil and gas formations.

OIL, GAS OR WATER RECORDS

CASING RECORD

FORMATION	CONTENT	FROM	TO	SIZE	PUT IN	PULLED OUT
				8-5/8"	249'	None

Describe in detail the manner in which the well was plugged, indicating where the mud fluid was placed and the method or methods used in introducing it into the hole. If cement or other plugs were used, state the character of same and depth placed, from feet to feet for each plug set.

Set first Plug at 540' w/20 sx cement  
Set 2nd Plug at 230' w/ 20 sx cement  
Set 3rd Plug at 40' w/10 sx cement & 1/2 sk hulls.

RECEIVED  
STATE CORPORATION COMMISSION

DEC 27 1965

CONSERVATION DIVISION  
Wichita, Kansas

(If additional description is necessary, use BACK of this sheet)

Name of Plugging Contractor Abercrombie Drilling, Inc.

Address 801 Union Center, Wichita, Kansas 67202

STATE OF Kansas, COUNTY OF Sedgwick, ss.

I, Mildred Saxton, Sec./Treas. of (contractor) of the above-described well, being first duly sworn on oath, says: That I have knowledge of the facts, statements, and matters herein contained and the log of the above-described well as filed and that the same are true and correct. So help me God.

(Signature) Mildred Saxton

801 Union Center, Wichita, Kansas, 67202 (Address)

SUBSCRIBED AND SWORN to before me this 23rd day of December, 19 65

Leola Joyce Hefke Notary Public.



CONTRACTOR'S WELL LOG

COMPANY: Rains & Williamson Oil Co.  
 CONTRACTOR: Abercrombie Drilling, Inc.  
 FARM: JENSEN #1  
 LOCATION: NE NE SW Sec. 34-11S-19W  
 Ellis County, Kansas  
 COMMENCED: December 9, 1965  
 COMPLETED: December 20, 1965

0	40	Rock
40	255	Clay - Shale
255	813	Sand & Shale
813	939	Shale & Shells
939	1063	Sand
1063	1384	Shale
1384	1422	Anhydrite
1422	1944	Shale & Shells
1944	2170	Shale & Lime Stringers
2170	3293	Lime & Shale
3293	3535	Lime
3535	3600	Lime & Chert
3600	3615	Lime
3615	3617	Shale
3617	3650	Dolomite Arbuckle
	3650	Rotary Total Depth

Set 8-5/8" surface casing at 249' w/175 sx common cement, 3% CC

DRY & ABANDONED

FORMATION TOPS:	ELEVATION:	
Heebner	3287'	(-1201)
Toronto	3305'	(-1219)
Lansing	3330'	(-1244)
Base Kansas City	3554'	(-1468)
Conglomerate	3582'	(-1496)
Simpson Shale	3612'	(-1526)
Arbuckle	3617'	(-1531)

2086' D. F. & K. B.  
 2080' G  
**RECEIVED**  
 STATE CORPORATION COMMISSION  
 DEC 27 1965  
 CONSERVATION DIVISION  
 Wichita, Kansas

STATE OF KANSAS )  
 ) SS  
 COUNTY OF SEDGWICK )

I, Mildred Saxton, do hereby certify that the above and foregoing is a true and correct copy of the log of the Jensen #1, NE NE SW Section 34-11S-19W, Ellis County, Kansas, as reflected by the files of Abercrombie Drilling, Inc.

Mildred Saxton  
 Mildred Saxton, Secretary-Treasurer

Subscribed and sworn to before me, a Notary Public, in and for Sedgwick County, Kansas, this 23rd day of December, 1965.

Leah Faye Hefke  
 Leah Faye Hefke, Notary Public

My commission expires June 16, 1967.

