


STATE OF KANSAS  
STATE CORPORATION COMMISSION

WELL PLUGGING RECORD

Give All Information Completely  
Make Required Affidavit  
Mail or Deliver Report to:  
Conservation Division  
State Corporation Commission  
212 No. Market  
Wichita, Kansas

NORTH

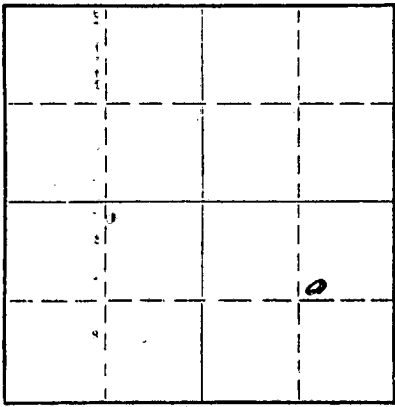

Locate well correctly on above  
Section Plat

Ellis County, Sec. 34 Twp. 11 Rge. 19 (W)  
Location as "NE/CNWxSWx" or footage from lines SW-NE-SE  
Lease Owner Hummon Oil, Inc.  
Lease Name Jensen Well No. 1  
Office Address 821 Union National Building, Wichita, Kansas 67202  
Character of Well (completed as Oil, Gas or Dry Hole) Dry Hole  
Date well completed 31 May 1968  
Application for plugging filed 31 May 1968  
Application for plugging approved 31 May 1968  
Plugging commenced 31 May 1968  
Plugging completed 31 May 1968  
Reason for abandonment of well or producing formation Dry Hole

If a producing well is abandoned, date of last production \_\_\_\_\_ 19\_\_\_\_  
Was permission obtained from the Conservation Division or its agents before plugging was commenced? Yes

Name of Conservation Agent who supervised plugging of this well Leo Massey  
Producing formation \_\_\_\_\_ Depth to top \_\_\_\_\_ Bottom \_\_\_\_\_ Total Depth of Well 3678 Feet  
Show depth and thickness of all water, oil and gas formations.

OIL, GAS OR WATER RECORDS

CASING RECORD

FORMATION	CONTENT	FROM	TO	SIZE	PUT IN	PULLED OUT

RECEIVED  
STATE CORPORATION COMMISSION  
JUN 21 1968  
CONSERVATION DIVISION  
Wichita, Kansas

Describe in detail the manner in which the well was plugged, indicating where the mud fluid was placed and the method or methods used in introducing it into the hole. If cement or other plugs were used, state the character of same and depth placed, from \_\_\_\_\_ feet to \_\_\_\_\_ feet for each plug set.

Set plug at 800' and put in 70 sacks of cement with pump truck.  
Set plug at 180' and put in 20 sacks of cement with pump truck.  
Set plug and hulls at 40' and put in 10 sacks cement.


(If additional description is necessary, use BACK of this sheet)

Name of Plugging Contractor Burt Drilling Company  
Address Great Bend, Kansas 67530

STATE OF KANSAS, COUNTY OF BARTON, ss.  
Duke C. Burt (employee of owner) or (owner or operator) of the above-described well, being first duly sworn on oath, says: That I have knowledge of the facts, statements, and matters herein contained and the log of the above-described well as filed and that the same are true and correct. So help me God.

(Signature) Duke C. Burt  
Great Bend, Kansas 67530  
(Address)

sworn to before me this 20th day of June, 1968

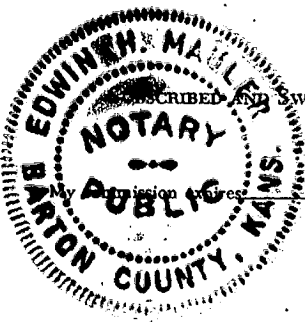

Edwin H. Mauler  
Edwin H. Mauler  
Notary Public.

July 2, 1969

HUMMON OIL, INC.  
 821 Union National Bank Building  
 Wichita, Kansas

Well: Jensen No. 1  
 Commenced R. D.: 5/21/68  
 Completed R. D.: 6/1/68  
 Total Depth: 3678' D. F.  
 Casing: Ran 201' of 8 5/8 24# 8rd. thd.  
 Used Surface Pipe

Sec.: 34-11-19  
 Ellis County, Kansas  
 Elevation:  
 Initial Prod.:  
 Contractor: BURT DRILLING  
 COMPANY

Strata	Depth
Post Rock	0- 75'
Gyp & Shale	75- 200
Shale	200- 420
Shale, Sand & Red Bed	420-1385
Shale & Red Bed	1385-1425
Anhydrite	1425-1469
Shale,	1469-1720
Shale & Lime Shells	1720-2095
Shale & Lime	2095-2490
Lime	2490-2680
Lime & Shale	2680-2980
Lime w/Shale Streaks	2980-3140
Lime	3140-3328
Heebner	3328-3332
Lime	3332-3586
B/K.C.	3586-3600
Conglomerate	3600-3660
Arbuckle	3660-3678

RECEIVED  
 STATE CORPORATION COMMISSION  
 JUN 21 1968  
 CONSERVATION DIVISION  
 Wichita, Kansas

I hereby certify that the above is a true and correct log of said well as reflected by daily reports.

BURT DRILLING CO.

*[Signature]*

Signed and sworn in my presence this Third day of May, 1968.



*[Signature]*  
 Notary Public  
 Edwin H. Mauler

My Commission Expires: July 2, 1969