


WELL PLUGGING RECORD

Give All Information Completely  
Make Required Affidavit  
Mail or Deliver Report to:  
Conservation Division  
State Corporation Commission  
800 Bitting Building  
Wichita, Kansas

Ellis County, Sec. 34 Twp. 11S Rge. (E) 19 (W)

Location as "NE/CNW%SW%" or footage from lines SW/4 SE/4 NE/4  
Lease Owner Skelly Oil Company  
Lease Name Jensen "B" Well No. 1  
Office Address Box 1650, Tulsa, Oklahoma  
Character of Well (completed as Oil, Gas or Dry Hole) Dry Hole  
Date well completed September 14, 19 53  
Application for plugging filed September 15, 19 53  
Application for plugging approved September 16, 19 53  
Plugging commenced September 14, 19 53  
Plugging completed September 15, 19 53  
Reason for abandonment of well or producing formation Dry Hole

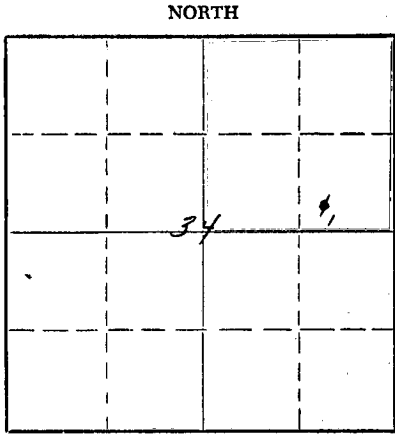

Locate well correctly on above Section Plat

If a producing well is abandoned, date of last production \_\_\_\_\_ 19\_\_\_\_  
Was permission obtained from the Conservation Division or its agents before plugging was commenced? Yes (verbally)

Name of Conservation Agent who supervised plugging of this well Mr. Eldon Petty  
Producing formation \_\_\_\_\_ Depth to top \_\_\_\_\_ Bottom \_\_\_\_\_ Total Depth of Well 3713 Feet  
Show depth and thickness of all water, oil and gas formations.

OIL, GAS OR WATER RECORDS

CASING RECORD

FORMATION	CONTENT	FROM	TO	OD SIZE	PUT IN	PULLED OUT
Arbuckle Lime	Dry	3673'	3713'	8-5/8"	1444' 9"	None

Describe in detail the manner in which the well was plugged, indicating where the mud fluid was placed and the method or methods used in introducing it into the hole. If cement or other plugs were used, state the character of same and depth placed, from \_\_\_\_\_ feet to \_\_\_\_\_ feet for each plug set.

25 sacks of cement 3713' to 3632'  
Mud laden fluid 3632' to 300'  
25 sacks of cement 300' to 224'  
Mud laden fluid 224' to 70'  
25 sacks of cement 70' to 6'  
Surface soil 6' to 0'

(If additional description is necessary, use BACK of this sheet)

Name of Plugging Contractor Chas. Hulme Drlg. Contr.  
Address Great Bend, Kansas

STATE OF Kansas, COUNTY OF Reno, ss.  
H. E. Wamsley (employee of owner) of the above-described well, being first duly sworn on oath, says: That I have knowledge of the facts, statements and matters herein contained and the log of the above-described well as filed and that the same are true and correct. So help me God.

(Signature) \_\_\_\_\_

Box 391, Hutchinson, Kansas  
(Address)

SUBSCRIBED AND SWORN to before me this 1st day of October, 19 53

My commission expires April 7, 1955

Josephine L. Johnson  
Notary Public.

24-2675-5 2-52-20M

**PLUGGING**  
FILE SEC 34T-11R-196  
BOOK PAGE 129 LINE 1

**RECEIVED**  
STATE CORPORATION COMMISSION  
OCT - 2 1953  
CONSERVATION DIVISION  
Wichita, Kansas

# SKELLY OIL COMPANY



## Well Record

Lease Name and No. **Jensen "B"** Well No. **1** Elev. **2138' AB**  
**2135' OP**  
 Lease Description **NE/4 Section 34-11S-19W**  
**Ellis County, Kansas (160 Acres)**

Location made **August 28, 1953** by **F. J. Cusson**  
**990** feet from North line **990** feet from East line  
**330** feet from South line **990** feet from West line of **Sec. 34**

Work com'd **8/29 1953** Rig comp'd **9/1 1953** Drlg. com'd **9/1 1953** Drlg. comp'd **9/14 1953**  
 Rig Contractor **Chas. Hulme Drlg. Contr.**  
 Drilling Contractor **Chas. Hulme Drlg. Contr., Great Bend, Kansas**  
 Rotary Drilling from **0'** to **3713'** Cable Tool Drilling from \_\_\_\_\_ to \_\_\_\_\_

Commenced Producing **DRY HOLE** 19 \_\_\_\_\_  
 Initial Prod. before shot or acid \_\_\_\_\_ Bbls.  
 Initial Prod. after shot or acid \_\_\_\_\_ Bbls.  
 Dry Gas Well Press \_\_\_\_\_ Volume \_\_\_\_\_ Cu. ft.  
 Casing Head Gas Pressure \_\_\_\_\_ Volume \_\_\_\_\_ Cu. ft.  
 Casing Head ( \_\_\_\_\_ Size ) Gas Pressure \_\_\_\_\_ Volume \_\_\_\_\_ Cu. ft.  
 Casing Head ( \_\_\_\_\_ Size ) Gas Pressure \_\_\_\_\_ Volume \_\_\_\_\_ Cu. ft.

PRODUCING FORMATION **DRY HOLE** (Name) Top \_\_\_\_\_ Bottom \_\_\_\_\_ TOTAL DEPTH **3713'**

### CASING RECORD

Casing Size	Wt.	Thds.	Where Set	PULLED OUT			LEFT IN			KIND	Cond'n	Sacks Used	CEMENTING Method Employed
				Jts.	Feet	In.	Jts.	Feet	In.				
8-5/8"	22.7	33					25	1010	5	Arbco 54	A		
8-5/8"	24.5	28	1450'				11	434	4	83 45	B	600	Halliburton
(8-5/8" casing set 2' in cellar)													

Liner Set at \_\_\_\_\_ Length \_\_\_\_\_ Perforated at \_\_\_\_\_  
 Liner Set at \_\_\_\_\_ Length \_\_\_\_\_ Perforated at \_\_\_\_\_  
 Packer Set at \_\_\_\_\_ Size and Kind \_\_\_\_\_  
 Packer Set at \_\_\_\_\_ Size and Kind \_\_\_\_\_

### SHOT OR ACID TREATMENT RECORD

Date	FIRST		SECOND		THIRD		FOURTH	
	Ft. and	Ft.	Ft. and	Ft.	Ft. and	Ft.	Ft. and	Ft.
Acid Used		Gals. Qts.		Gals. Qts.		Gals. Qts.		Gals. Qts.
Size Shot								
Shot Between								
Size of Shell								
Put in by (Co.)								
Length anchor								
Distance below Cas'g								
Damage to Casing or Casing Shoulder								

### SIGNIFICANT GEOLOGICAL FORMATIONS

NAME	Top	Bottom	GAS		OIL		REMARKS
			From	To	From	To	
Topeka Limestone	3143'						
Heebner shale	3341'						
Toronto Limestone	3361'						
Lansing Limestone	3386'						
Conglomerate	3657'						
Simpson	3672'						
Arbuckle Limestone	3673'						

### CLEANING OUT RECORDS

	DATE COMMENCED	DATE COMPLETED	PROD. BEFORE	PROD. AFTER	REMARKS
1st					See Reverse for other details.
2nd					" " " " "
3rd					" " " " "
4th					" " " " "

### PLUGGING BACK AND DEEPENING RECORDS

	Date Commenced	Date Completed	No. Feet Plugged Back or Deepened	Prod. Before	Prod. After	REMARKS
1st						See Reverse for other details.
2nd						" " " " "
3rd						" " " " "
4th						" " " " "

(See Reverse for Record of Formation)

# RECORD OF FORMATIONS

FORMATION	TOP	BOTTOM	REMARKS
Surface soil and sand	0	40	
Shale and shells	40	675	
Sand	675	860	
Shale and shells	860	1440	
Anhydrite	1440	1450	
Casing Record			
Anhydrite	1450	1485	
Clay	1485	1650	
Red bed and shale	1650	2090	
Shale and lime	2090	2285	
Lime	2285	2425	
Lime and shale	2425	2735	
Shale	2735	2765	
Lime and shale	2765	2855	
Shale	2855	2935	
Lime and shale	2935	3143	
Fine crystalline lime	3143	3154	

FORMATION	TOP	BOTTOM	REMARKS
Lime	3154	3185	
Lime and shale	3185	3305	
White finely crystalline dense lime	3305	3311	
Lime	3311	3341	
Lime and shale	3341	3417	
Gray, finely crystalline mostly dense lime	3417	3425	
Lime	3425	3572	
White crystalline lime	3572	3583	

Spotted stain, fair porosity  
 TOP MEMBER SHALES 3341'  
 TOP TORONTO LIME 3341'  
 TOP LANSING LIME 3341'

FORMATION	TOP	BOTTOM	REMARKS
Lime	3583	3592	
Lime and shale	3592	3673	
Fine grained, medium crystalline dolomite	3673	3677	
Medium grained crystalline dolomite	3677	3681	

Fair to poor porosity, saturation and stain, some free oil in wet samples.  
 Man Halliburton drill stem test, packer set at 3675', used 6' anchor, open 30 minutes, recovered 5' of rotary mud, no oil, BHP-580.

FORMATION	TOP	BOTTOM	REMARKS
Gray to brown, medium crystalline dolomite	3681	3694	
White, medium coarsely crystalline dolomite	3694	3713	

Spotty porosity and stain  
 Man Halliburton drill stem test, packer set at 3676', used 18' anchor, open 30 minutes, weak blow for 3 minutes, recovered 5' of rotary mud, no oil, BHP-570.


Man Halliburton drill stem test, packer set at 3675', used 35' anchor, open 1 hour, fair blow recovered 5' of salt water, no oil, BHP-535.

Since no commercial shows of oil or gas were encountered in drilling to 3713', regular authority was granted to plug and abandon the well. Well was plugged as follows:

SLOPE TEST DATA: 125'-1250' inc., 1/2 degree deviation; 1750' to 3000' inclusive, no deviation from vertical.