


STATE OF KANSAS
STATE CORPORATION COMMISSION

WELL PLUGGING RECORD

Give All Information Completely
Make Required Affidavit
Mail or Deliver Report to
Conservation Division
State Corporation Comm.
245 North Water
Wichita, KS 67202

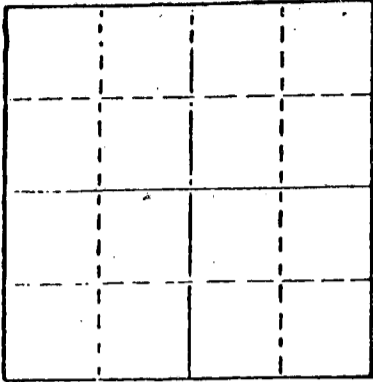

Locate well correctly on above
Section Plat

Ellis County. Sec. 31 Twp. 11S Rge. 19 E/W
Location as "NE/CNW1SW1" or footage from lines
440' E N L W & (440' E E L C S W / 4

Lease Owner Don E. Pratt
Lease Name SCHNIDER Well No. 1-31
Office Address Box 370, Hays, KS 67601
Character of Well (Completed as Oil, Gas or Dry Hole) _____

Dry Hole
Date Well completed October 24 1978
Application for plugging filed October 24 1978
Application for plugging approved October 24 1978
Plugging commenced October 24 1978
Plugging completed October 24 1978

Reason for abandonment of well or producing formation _____
D&A
If a producing well is abandoned, date of last production _____
19____

Was permission obtained from the Conservation Division or
its agents before plugging was commenced? yes

Name of Conservation Agent who supervised plugging of this well Leo Massey
Producing formation _____ Depth to top _____ Bottom _____ Total Depth of Well 3771
Show depth and thickness of all water, oil and gas formations.

OIL, GAS OR WATER RECORDS

CASING RECORD

FORMATION	CONTENT	FROM	TO	SIZE	PUT IN	PULLED OUT
				8-5/8"	155'	-----

Describe in detail the manner in which the well was plugged, indicating where the mud fluid
was placed and the method or methods used in introducing it into the hold. If cement or other
plugs were used, state the character of same and depth placed, from _____ feet to
_____ feet for each plug set.

1st plug @ 600' w/70 sx, 50-50 posmix, 6% gel
2nd plug @ 150' w/20 sx, 50-50 posmix, 6% gel
3rd plug @ 40' w/10 sx, 50-50 posmix, 6% gel

RECEIVED
STATE CORPORATION COMMISSION

NOV 17 1978

11-17-1978

CONSERVATION DIVISION

Wichita, Kansas

(If additional description is necessary, use BACK of this sheet)

Name of Plugging Contractor Murfin Drilling Company

STATE OF KANSAS COUNTY OF SEDGWICK, ss.
Wm. S. Shropshire of Murfin Drilling Company (employee of owner) or (owner or operator)
of the above-described well, being first duly sworn on oath, says: That I have knowledge of
the facts, statements, and matters herein contained and the log of the above-described well
as filed and that the same are true and correct. So help me God.

(Signature) Wm. S. Shropshire
Wm. S. Shropshire, Asst. Gen. Mgr.
617 Union Center, Wichita, KS 67202
(Address)

SUBSCRIBED AND SWORN TO before me this 15th day of November, 1978

Kerran Lidia
Kerran Lidia Notary Public.

My commission expires

KERRAN LIDIA
STATE NOTARY PUBLIC
SEDGWICK COUNTY, KANSAS
MY APPT. EXP. Feb. 1, 1982

WELL LOG

COMPANY Don E. Pratt

SEC. 31 T. 11S R. 19W
LOC. 440' FNL & 440' FEE SW/4

FARM SCHNIDER NO. 1-31


RIG. NO. 15

TOTAL DEPTH 3771'

COMM. October 19, 1978 COMP. October 24, 1978

CONTRACTOR Murfin Drilling Company

COUNTY Ellis
KANSAS

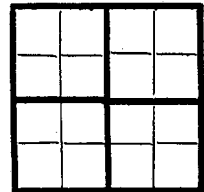

CASING

20	10
15	8 -5/8" @ 155' w/130 sx.
12	6
13	5

ELEVATION

PRODUCTION

FIGURES INDICATE BOTTOM OF FORMATIONS

40'	Surface soils & Clay
125'	Clay & Sand
185'	Shale
970'	Shale, Shells & Sand
1190'	Sand
1507'	Shale (red Beds)
1556'	Anhydrite
2480'	Shale
3465'	Shale & Lime
3771'	Lime RTD

RECEIVED
STATE CERTIFICATION COMMISSION

NOV 17 1973

CONSERVATION DIVISION
Wichita, Kansas

State of KANSAS
County of SEDGWICK } ss:

I, Wm. S. Shropshire of the Murfin Drilling Company

upon oath state that the above and foregoing is a true and correct copy of the log of the SCHNIDER #1 well.

Wm. S. Shropshire
Wm. S. Shropshire, Asst. Gen. Mgr.

Subscribed and sworn to before me this 15th day of November 19 78

My Commission Expires:

KERRAN LIDIA
STATE NOTARY
SEDGWICK COUNTY, KANSAS
MY APPT. EXP. Feb. 6, 1982

Kerran Lidia
NOTARY PUBLIC

Kerran Lidia