

STATE OF KANSAS
STATE CORPORATION COMMISSION

Give All Information Completely
Make Required Affidavit
Mail or Deliver Report to:
Conservation Division
State Corporation Commission
11 No. Broadway
Wichita, Kansas

WELL PLUGGING RECORD

Ellis County, Sec. 31 Twp. 11S Rge. (E) 19 (W)

Location as "NE/CNW%SW%" or footage from lines SW SW NW

Lease Owner Graybol Oil Corporation

Lease Name Zerfas Well No. 1

Office Address 2200 National Bank of Tulsa Bldg., Tulsa 3, Oklahoma

Character of Well (completed as Oil, Gas or Dry Hole) Dry Hole

Date well completed August 8 19 62

Application for plugging filed August 8 19 62

Application for plugging approved August 8 19 62

Plugging commenced August 8 19 62


Plugging completed August 8 19 62

Reason for abandonment of well or producing formation Dry Hole

If a producing well is abandoned, date of last production _____ 19 _____

Was permission obtained from the Conservation Division or its agents before plugging was commenced? Yes

NORTH

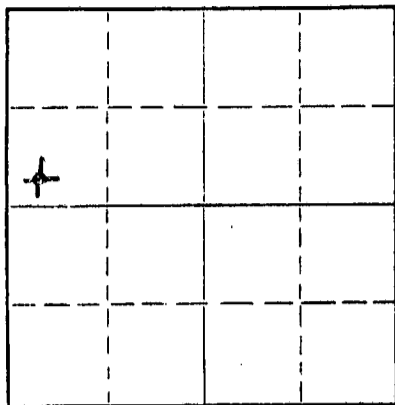

Locate well correctly on above
Section Plat

Name of Conservation Agent who supervised plugging of this well Eldon Petty

Producing formation _____ Depth to top _____ Bottom _____ Total Depth of Well 3830 Feet

Show depth and thickness of all water, oil and gas formations.

OIL, GAS OR WATER RECORDS

CASING RECORD

FORMATION	CONTENT	FROM	TO	SIZE	PUT IN	PULLED OUT
Topeka	Salt water	3223	3239	8 5/8"	171	None
Lansing	Salt water	3482	3503			
Conglomerate	Salt water	3784	3830			

Describe in detail the manner in which the well was plugged, indicating where the mud fluid was placed and the method or methods used in introducing it into the hole. If cement or other plugs were used, state the character of same and depth placed, from _____ feet to _____ feet for each plug set.

Filled hole with heavy mud-laden fluid. Squeezed 20 sacks of cement through drill pipe @ 550'. Squeezed 20 sacks of cement through drill pipe @ 170'. Squeezed 10 sacks of cement to the top of the surface casing.

RECEIVED
STATE CORPORATION COMMISSION

AUG 1 1962
08-01-62
CONSERVATION DIVISION

(If additional description is necessary, use BACK of this sheet)

Name of Plugging Contractor Graybol Oil Corporation

Address 2200 N. B. T. Bldg., Tulsa, Oklahoma

STATE OF OKLAHOMA, COUNTY OF Tulsa, ss.


Lyman C. Dennis (employee of owner) or (owner or operator) of the above-described well, being first duly sworn on oath, says: That I have knowledge of the facts, statements, and matters herein contained and the log of the above-described well as filed and that the same are true and correct. So help me God.

(Signature) Lyman C. Dennis

Tulsa, Oklahoma
(Address)

Subscribed and sworn to before me this 13th day of August, 19 62

My commission expires October 8, 1962 James Lawrence Notary Public.

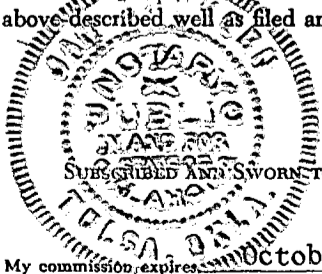

GRAYBOL OIL CORPORATION

Ellis County, Kansas

No. 1 Zerfas SW SW NW

Section 31-11S-19W

Contractor: Company Tools

Elev: K.B. 2103' D.F. 2103'

G.L. 2097'

Commenced: July 29, 1962

Completed: August 8, 1962

Production: Dry & Abandoned

CASING RECORD

171' 8 5/8" cemented with 140 sacks cement

DEPTHFORMATION

0-175	Rock and Shale
175-950	Shale and Shells
950-1000	Sand and Shells
1000-1150	Sand
1150-1473	Shale and Red Bed
1473-1515	Anhydrite
1515-1635	Shale and Lime
1635-2150	Shale and Shells
2150-2220	Lime and Shale
2220-2330	Lime
2330-2375	Shale and Lime
2375-2430	Lime and Shale
2430-2445	Sand and Shale
2445-2635	Shale and Lime
2635-2775	Lime and Shale
2775-2820	Lime and Sand
2820-3147	Shale and Lime
3147-3170	Lime
3170-3185	Shale and Lime
3185-3395	Lime and Shale
3395-3461	Shale and Lime
3461-3692	Lime
3692-3755	Shale and Lime
3755-3805	Shale, Lime and Chert
3805-3830	Lime with Chert

Welex Electric Log Tops:

Anhydrite	1473
Topeka LS.	3143
Heebner Sh.	3364
Toronto Ls.	3389
Lansing Ls.	3406
Base of K.C.	3616
Arbuckle Not Reached	

RECEIVED
STATE CORPORATION COMMISSION

AUG 14 1962

CONSERVATION DIVISION
Wichita, Kansas

Driller's T. D. 3830'

Welex 3831'

I hereby certify that the above is a true and correct log of the above captioned well as taken directly from the daily drilling reports.

GRAYBOL OIL CORPORATION

By: Lyman C. Dennis
Lyman C. Dennis, Geologist

Subscribed and sworn to the 9th day of August, 1962.

My commission expires: October 8, 1962

Jan Lawrence
NOTARY PUBLIC

LCD:jec