

EFFECTIVE DATE: 3-12-2001  
DISTRICT # 1  
SSA? Yes  No

State of Kansas  
NOTICE OF INTENTION TO DRILL

FORM MUST BE TYPED  
FORM MUST BE SIGNED  
ALL BLANKS MUST BE FILLED

Must be approved by the K.C.C. five (5) days prior to commencing well

Expected Spud Date ..... month ..... day ..... year .....  
Spot Approx. C NW Sec 30 Twp 19 S. Rg 21 East  West

OPERATOR: License # 4767  
Name: Ritchie Exploration, Inc.  
Address: P.O. Box 783188  
City/State/Zip: Wichita, KS 67278  
Contact Person: Rocky Milford  
Phone: 316/691-9500

1340 feet from South / North line of Section  
1340 feet from East / West line of Section  
IS SECTION  REGULAR  IRREGULAR?

(NOTE: Locate well on the Section Plat on Reverse Side)  
County: Ness  
Lease Name: Moore D-P Well #: 7  
Field Name: Schaben

CONTRACTOR: License #: .....  
Name: .....  
**ADVISE ON ACO-1; MUST BE LICENSED WITH KCC**

Is this a Prorated/Spaced Field?  yes  no  
Target Formation(s): Mississippian  
\* Nearest lease or unit boundary: 1340 20' UNIT LINE  
Ground Surface Elevation: 2275 est. .... feet MSL

Well Drilled For: Well Class: Type Equipment:  
 Oil  Enh Rec  Infield  Mud Rotary  
 Gas  Storage  Pool Ext.  Air Rotary  
 OUVO  Disposal  Wildcat  Cable  
 Seismic; # of Holes  Other  
 Other

Water well within one-quarter mile: .... yes  no  
Public water supply well within one mile: .... yes  no  
Depth to bottom of fresh water: 500' 280'  
Depth to bottom of usable water: 700' 620'

If OUVO: old well information as follows:  
Operator: .....  
Well Name: .....  
Comp. Date: ..... Old Total Depth: .....

Surface Pipe by Alternate: .... 1  2  
Length of Surface Pipe Planned to be set: 300'  
Length of Conductor pipe required: none  
Projected Total Depth: 4500'  
Formation at Total Depth: Mississippian

Directional, Deviated or Horizontal wellbore? .... yes  no  
If yes, true vertical depth: .....  
Bottom Hole Location: .....

Water Source for Drilling Operations:  
... well  farm pond  other  
DWR Permit #: .....  
Will Cores Be Taken?: .... yes  no  
If yes, proposed zone: .....

**AFFIDAVIT** \*W.L.E. DOCKET NO. 01-CONS-180-CWLE

The undersigned hereby affirms that the drilling, completion and eventual plugging of this well will comply with K.S.A. 55-101, et. seq.  
It is agreed that the following minimum requirements will be met:

1. Notify the appropriate district office prior to spudding of well;
2. A copy of the approved notice of intent to drill shall be posted on each drilling rig;
3. The minimum amount of surface pipe as specified below shall be set by circulating cement to the top; in all cases surface pipe shall be set through all unconsolidated materials plus a minimum of 20 feet into the underlying formation;
4. If the well is dry hole, an agreement between the operator and the district office on plug length and placement is necessary prior to plugging;
5. The appropriate district office will be notified before well is either plugged or production casing is cemented in;
6. IF AN ALTERNATE-II COMPLETION, PRODUCTION PIPE SHALL BE CEMENTED FROM BELOW ANY USABLE WATER TO SURFACE WITHIN 120 DAYS OF SPUD DATE. IN ALL CASES, NOTIFY DISTRICT OFFICE PRIOR TO ANY CEMENTING.

I hereby certify that the statements made herein are true and to the best of my knowledge and belief.  
Date: 12/23/2002 ... Signature of Operator or Agent: Rocky Milford Title: Geologist

FOR KCC USE: API # 15- 135-24137-0000  
Conductor pipe required NONE feet  
Minimum surface pipe required 300 feet per Alt.  2  
Approved by: JK 3-7-2001  
This authorization expires: 9-7-2001  
(This authorization void if drilling not started within 6 months of effective date.)  
Spud date: \_\_\_\_\_ Agent: \_\_\_\_\_

RECEIVED  
KANSAS CORPORATION COMMISSION  
DEC 28 2000  
12-28-2000  
CONSERVATION DIVISION  
WICHITA, KS

REMEMBER TO:

- File Drill Pit Application (form CDP-1) with Intent to Drill;
- File Completion Form ACO-1 within 120 days of spud date;
- File acreage attribution plat according to field proration orders;
- Notify appropriate district office 48 hours prior to workover or re-entry;
- Submit plugging report (CP-4) after plugging is completed;
- Obtain written approval before disposing or injecting salt water.

Mail to: Conservation Division, 200 Colorado Derby Building, 202 W. First St., Wichita, Kansas 67202-1286.

IN ALL CASES PLOT THE INTENDED WELL ON THE PLAT BELOW

PLAT OF ACREAGE ATTRIBUTABLE TO A WELL IN A PRORATED OR SPACED FIELD X

If the intended well is in a prorated or spaced field, please fully complete this side of the form. If the intended well is in a prorated or spaced field complete the plat below showing that the well will be properly located in relationship to other wells producing from the common source of supply. Please show all the wells within 1 mile of the boundaries of the proposed acreage attribution unit for gas wells and within 1/2 mile of the boundaries of the proposed acreage attribution unit for oil wells. SEE EXHIBIT 'A'

API NO. 15- \_\_\_\_\_  
 OPERATOR Ritchie Exploration, Inc.  
 LEASE Moore D-P  
 WELL NUMBER 7  
 FIELD Schaben

LOCATION OF WELL: COUNTY Ness  
1340 feet from south/~~north~~ line of section  
1340 feet from east/~~west~~ line of section  
 SECTION 30 TWP 19S RG 21W



NUMBER OF ACRES ATTRIBUTABLE TO WELL <sup>40</sup> 160  
 QTR/QTR/QTR OF ACREAGE SE C - NW - \_\_\_\_\_

IS SECTION x REGULAR or \_\_\_\_\_ IRREGULAR  
IF SECTION IS IRREGULAR, LOCATE WELL FROM NEAREST CORNER BOUNDARY.

Section corner used: \_\_\_\_\_ NE \_\_\_\_\_ NW \_\_\_\_\_ SE \_\_\_\_\_ SW

**PLAT**

(Show location of the well and shade attributable acreage for prorated or spaced wells.)  
 (Show footage to the nearest lease or unit boundary line.)

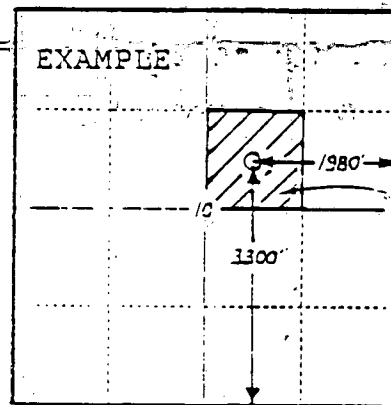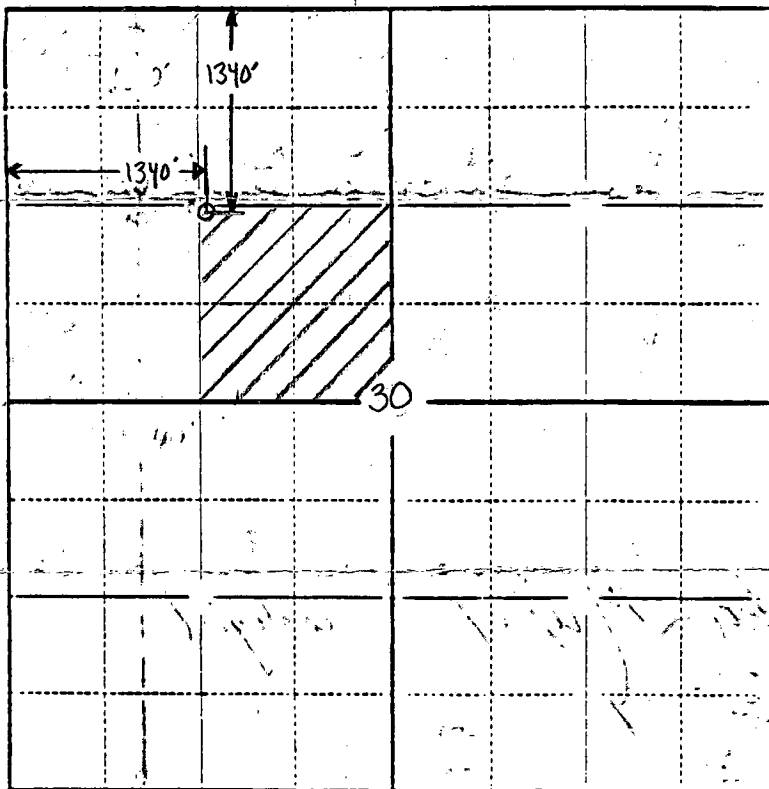

40 ACRES

SEWARD CO.

SEE EXHIBIT 'A'

In plotting the proposed location of the well, you must show:

- 1) The manner in which you are using the depicted plat by identifying section lines, i.e. 1 section, 1 section with 8 surrounding sections, 4 sections, etc.;
- 2) the distance of the proposed drilling location from the section's south/north and east/west lines; and
- 3) the distance to the nearest lease or unit boundary line.