

15-135-30035-00-00

STATE OF KANSAS
STATE CORPORATION COMMISSION

Form CP-4


WELL PLUGGING RECORD

Give All Information Completely
Make Required Affidavit
Mail or Deliver Report to:
Conservation Division
State Corporation Commission
211 No. Broadway
Wichita, Kansas

Ness County. Sec. 31 Twp. 19S Rge. 21 (E) W (W)

Location as "NE/CNW4SW4" or footage from lines C NW/4 SE/4
Lease Owner Operator: Walters Drilling Co.
Lease Name PETERSILIE Well No. 1
Office Address 510 Orpheum Building, Wichita, Kansas 67202
Character of Well (completed as Oil, Gas or Dry Hole) Dry Hole
Date well completed April 3, 19 65
Application for plugging filed (verbal) April 3, 19 65
Application for plugging approved (verbal) April 3, 19 65
Plugging commenced April 4, 19 65
Plugging completed April 4, 19 65
Reason for abandonment of well or producing formation Dry Hole

NORTH

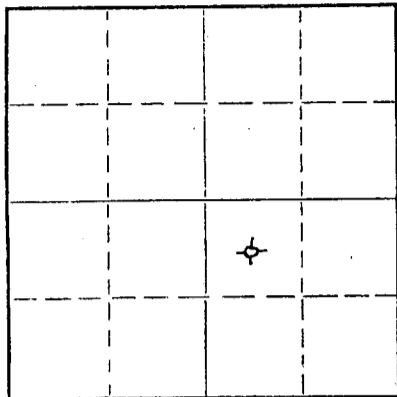

Locate well correctly on above
Section Plat

If a producing well is abandoned, date of last production 19
Was permission obtained from the Conservation Division or its agents before plugging was commenced? Yes

Name of Conservation Agent who supervised plugging of this well Eldon Petty
Producing formation Depth to top Bottom Total Depth of Well 4422 Feet
Show depth and thickness of all water, oil and gas formations.

OIL, GAS OR WATER RECORDS

CASING RECORD

FORMATION	CONTENT	FROM	TO	SIZE	PUT IN	PULLED OUT
		0	520'	8-5/8"	520'	none

Describe in detail the manner in which the well was plugged, indicating where the mud fluid was placed and the method or methods used in introducing it into the hole. If cement or other plugs were used, state the character of same and depth placed, from feet to feet for each plug set.

Set bottom plug at 510' with 1/4 sack hulls, 20 sacks cement.
Set center plug at 240' with 1/4 sack hulls, 20 sacks cement.
Set top plug at 40' with 1/4 sack hulls, 10 sacks cement.

RECEIVED
STATE CORPORATION COMMISSION


APR 9 1965
04-09-1965
CONSERVATION DIVISION
Wichita, Kansas

(If additional description is necessary, use BACK of this sheet)
Name of Plugging Contractor Birmingham-Bartlett Drilling Co.
Address 300 Kaufman Building, Wichita, Kansas 67202

STATE OF KANSAS, COUNTY OF SEDGWICK ss.
Richard Hindery, partner of Birmingham-Bartlett Drilling Co. contractor
well, being first duly sworn on oath, says: That I have knowledge of the facts, statements, and matters herein contained and the log of the above-described well as filed and that the same are true and correct. So help me God. BIRMINGHAM-BARTLETT DRILLING CO.

(Signature) By Richard Hindery Partner
300 Kaufman Building Wichita, Kansas
(Address)

SUBSCRIBED AND SWORN to before me this 5th day of April, 19 65.

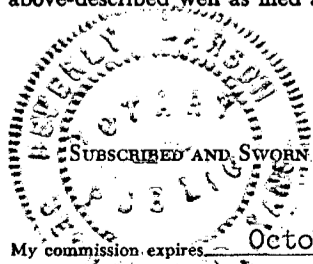

Beverly Larson
Notary Public.

15-135-30035-00-00

PETERSILIE NO. 1 WELL

LOCATION: C NW/4 SE/4
Section 31-19S-21W
Ness County, Kansas

SPUDED: 3-19-65
DRILLING
COMPLETED: 4-3-65

OPERATOR: Walters Drilling Co.
510 Orpheum Building
Wichita, Kansas 67202

CONTRACTOR: Birmingham-Bartlett Drilling Co.
300 Kaufman Building
Wichita, Kansas 67202

SURFACE CASING: 8-5/8" 20# casing cemented at
520' with 290 sacks cement and
75 sacks chloride.

OIL STRING: None set. Dry hole.
Plugged 4-4-65.

LOG

(Figures indicate bottom of formation)

0 -	40	Surface clay
	520	Sand, shale and shells
	833	Shale and shells
	843	Anhydrite
	935	Shale and shells
	1165	Sand
	1495	Red bed and shale
	1529	Stone corral
	1685	Shale
	2190	Shale and shells
	3405	Shale and lime
	3510	Lime
	3750	Lime and shale
	3808	Lime
	3979	Shale and lime
	4035	Lime
	4286	Lime and shale
	4422	Lime
	4422	Rotary Total Depth Dry Hole

APR 5 1965
04-09-1965

The undersigned, Richard Hindery, one of the partners of Birmingham-Bartlett Drilling Co., hereby certifies that the above is a true and correct log of the Petersilie No. 1 Well as shown in the daily drilling reports.

BIRMINGHAM-BARTLETT DRILLING CO.

By Richard Hindery
Richard Hindery, Partner

Subscribed and sworn to before me
this 5th day of April, 1965.

Beverly Larson

Beverly Larson, Notary Public

My commission expires October 2, 1966.