


STATE OF KANSAS
STATE CORPORATION COMMISSION

WELL PLUGGING RECORD

Give All Information Completely
Make Required Affidavit
Mail or Deliver Report to
Conservation Division
State Corporation Comm.
245 North Water
Wichita, KS 67202

Ness County. Sec. 31 Twp. 19S Rge. 21W E/W
Location as "NE/CNW 1/4 SW 1/4" or footage from lines

C SE SE
Lease Owner Martin Explorations
Lease Name Reinert Well No. #1
Office Address 527 Union Center Bldg., Wichita, Kansas 67202
Character of Well (Completed as Oil, Gas or Dry Hole)

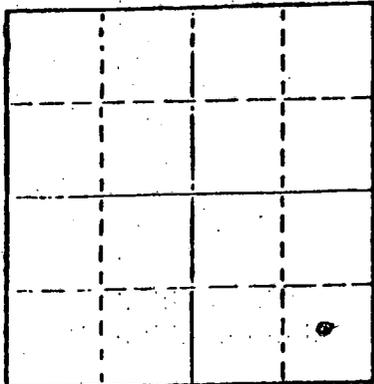

Locate well correctly on above Section Plat

dry hole
Date Well completed July 14, 1978 19
Application for plugging filed July 14, 1978 19
Application for plugging approved July 14, 1978 19
Plugging commenced July 14, 1978 19
Plugging completed July 14, 1978 19
Reason for abandonment of well or producing formation
dry hole

If a producing well is abandoned, date of last production 19

Was permission obtained from the Conservation Division or its agents before plugging was commenced? yes

Name of Conservation Agent who supervised plugging of this well Leo Massey
Producing formation Depth to top Bottom Total Depth of Well 4417'
Show depth and thickness of all water, oil and gas formations.

OIL, GAS OR WATER RECORDS

CASING RECORD

FORMATION	CONTENT	FROM	TO	SIZE	PUT IN	PULLED OUT

Describe in detail the manner in which the well was plugged, indicating where the mud fluid was placed and the method or methods used in introducing it into the hold. If cement or other plugs were used, state the character of same and depth placed, from feet to feet for each plug set. Hole plugged with 50-50 pozmix, 2% gel, as follows:
50 sacks @ 550', 25 sacks @ 300', hulls and 10 sacks @ 40'. Plugging completed at 10:00 p.m., July 14, 1978.

RECEIVED
STATE CORPORATION COMMISSION
JUL 26 1978
07-26-1978
CONSERVATION DIVISION
Wichita, Kansas

(If additional description is necessary, use BACK of this sheet)
Name of Plugging Contractor

STATE OF KANSAS COUNTY OF BARTON, ss.
Kenneth J. Link (employee of owner) or (owner or operator)
of the above-described well, being first duly sworn on oath, says: That I have knowledge of the facts, statements, and matters herein contained and the log of the above-described well as filed and that the same are true and correct. So help me God.

(Signature) Kenneth J. Link President
P.O. Box 355, Great Bend, Kansas 67530
(Address)

SUBSCRIBED AND SWORN TO before me this 21st day of July, 1978.

Loneita Barry
Loneita Barry Notary Public.

My commission expires 3-28-80.



15-135-21472-00-00

DRILLERS LOG

#1 Reinert

CASING RECORD:
11 jts. new 20#
8-5/8" surface
casing.

COMPANY: Martin Explorations
CONTRACTOR: Strata Drilling Company
COMMENCED: July 8, 1978
COMPLETED: July 14, 1978

DESCRIPTION: C SE SE
Section 31-19S-21W
Ness County, Kansas

ELEVATION: 2248' GL

TOTAL ROTARY
DEPTH: 4417'

D & A

<u>FORMATION</u>	<u>FROM</u>	<u>TO</u>	<u>REMARKS</u>
Surface soil, shale	0	460	Ran 445' new 20# 8-5/8" surface casing; set and cemented @ 450' with 270 sacks common cement, 2% gel, 3% C.C. Cement circulated. Plug down at 3:45 a.m., July 9, 1978.
Shale	460	620	
Shale, red bed, sand	620	1484	
Anhydrite	1484	1518	
Shale	1518	2425	
Lime and shale	2425	4417	

Ran one drill stem test.

Hole plugged with 50-50 pozmix, 2% gel as follows: 50 sacks @ 550', 25 sacks @ 300', Hulls and 10 sacks @ 40'. Plugging completed @ 10:00 p.m., July 14, 1978.

RECEIVED
STATE CORPORATION COMMISSION
SEP 22 1978
09-22-1978
CONSERVATION DIVISION
Wichita, Kansas

STATE OF KANSAS)
) ss
COUNTY OF BARTON)

I certify that this is a true and correct copy of the above log to the best of my knowledge.

STRATA DRILLING COMPANY

Kenneth J. Link
Kenneth J. Link, President

Sworn to and subscribed before me this 21st day of July, 1978.

My appointment expires 3-28-80.

Loneita Barry
Loneita Barry, Notary Public

