


STATE OF KANSAS
ST. CORPORATION COMMISSION

Give All Information Completely
Make Request to Plavitt
Mail or Deliver Report to:
Conservation Division
State Corporation Commission
800 Bittling Building
Wichita, Kansas

WELL PLUGGING RECORD

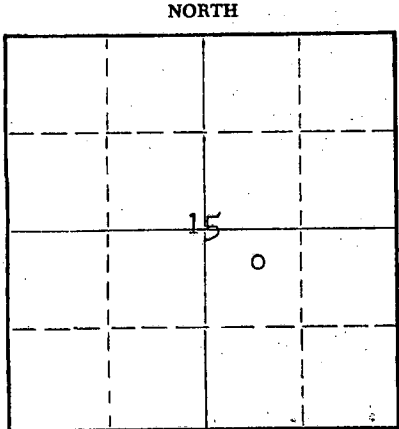

Locate well correctly on above
Section Plat

Ellis County. Sec. 15 Twp. 15 Rge. 18 (E) (W)
Location as "NE/CNW/SW" or footage from lines NE NW SE
Lease Owner Frontier Oil Company
Lease Name Al Wasinger Well No. 2
Office Address 536 Petroleum Building, Wichita 2, Kansas
Character of Well (completed as Oil, Gas or Dry Hole) Lost Hole
Date well completed June 29 19 55
Application for plugging filed July 21 19 55
Application for plugging approved June 29 (Oral) 19 55
Plugging commenced June 29 19 55
Plugging completed June 29 19 55
Reason for abandonment of well or producing formation Lost Hole

If a producing well is abandoned, date of last production 19
Was permission obtained from the Conservation Division or its agents before plugging was commenced? Eldon Petty, Box 326, Hays, Kansas

Name of Conservation Agent who supervised plugging of this well
Producing formation Depth to top Bottom Total Depth of Well 3101 Feet
Show depth and thickness of all water, oil and gas formations.

OIL, GAS OR WATER RECORDS

CASING RECORD

FORMATION	CONTENT	FROM	TO	SIZE	PUT IN	PULLED OUT
				8-5/8"	1134'	None


Describe in detail the manner in which the well was plugged, indicating where the mud fluid was placed and the method or methods used in introducing it into the hole. If cement or other plugs were used, state the character of same and depth placed, from feet to feet for each plug set.

Filled hole with mud and squeezed with
80 sacks cement to top.

(If additional description is necessary, use BACK of this sheet)
Name of Plugging Contractor Rocket Drilling Company, Inc.
Address 352 North Broadway, Wichita 2, Kansas


STATE OF KANSAS, COUNTY OF SEDGWICK, ss.
L. H. Myrick (employee of owner) of the above-described
well, being first duly sworn on oath, says: That I have knowledge of the facts, statements, and matters herein contained and the log of the
above-described well as filed and that the same are true and correct. So help me God.
(Signature) L. H. Myrick
352 North Broadway, Wichita 2, Kansas (Address)

SUBSCRIBED AND SWORN to before me this 21st day of July 19 55
My commission expires March 5, 1958
Patricia MacBlume Notary Public.

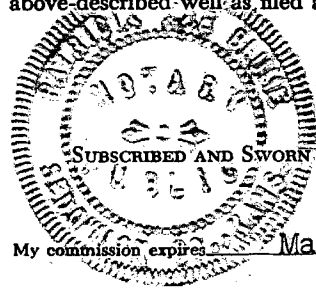

PLUGGING
FILE SEC-15-T-15-R-184
BOOK PAGE 131 LINE 6

CONSERVATION DIVISION
WICHITA, KANSAS

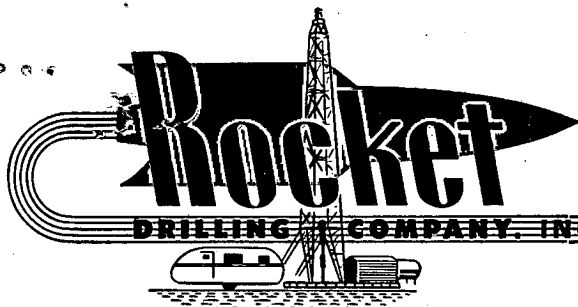

DRILLING COMPANY, INC. Forest 3-1279 352 N. BROADWAY WICHITA, KANSAS

Frontier Oil Company
#2 Al Washinger
NE NW SE Section 15-15-18W
Ellis County, Kansas

Frontier Oil Company
536 Petroleum Building
Wichita 2, Kansas

Elevation: 2012 R.B.
Spudded: June 21, 1955
Lost Hole: June 28, 1955
Abandoned: June 29, 1955
Contractor: Rocket Drilling Company, Inc.

CASING RECORD

1134' of 8-5/8" O.D. 24# seamless casing cemented with 500 sacks cement, 5% gel.

DRILLERS LOG

Clay & Rock	0 to 200	Shale, Shells & Lime Streaks	1875
Blue Shale	350	Shale & Shells	1990
Sand & Shale	400	Shale & Lime	2120
Shale	530	Broken Lime	2435
Sand Streaks	549	Lime, Broken Shale Streaks	2595
Sand	825	Lime	2750
Shale	1175	Shale & Lime Streaks	2902
Anhydrite	1210	Broken Lime	3032
Shale & Shells	1525	Lime	3101 TD

STATE OF KANSAS)
COUNTY OF SEDGWICK) SS:

I hereby certify that to the best of my knowledge and belief, the foregoing log is true and correct.

ROCKET DRILLING COMPANY, INC.

L. H. Myrick

L. H. Myrick

Subscribed and sworn to before me, a Notary Public, in and for the County and State aforesaid, this 21st day of July, 1955.

Patricia M. Blume
Notary Public

My commission expires: March 5, 1958.

