

CARD MUST BE TYPED

State of Kansas

CARD MUST BE SIGNED

# NOTICE OF INTENTION TO DRILL

(see rules on reverse side)

✓  
10

Expected Spud Date. 10 18 88  
month day year

API Number 15-109-20,468-0000

100' SE \_\_\_\_\_ East  
S/2 NW NE Sec. 3 Twp. 12 S, Rg. 34 \_\_\_\_\_ West  
4220 Ft. from South Line of Section  
1910 Ft. from East Line of Section

OPERATOR: License # 5364  
Name BEREN CORPORATION  
Address 970 Fourth Financial Center  
City/State/Zip Wichita, KS 67202  
Contact Person Evan C. Mayhew  
Phone (316) 265-3311

(Note: Locate well on Section Plat on reverse side)  
Nearest lease or unit boundary line 730 feet

County Logan  
Lease Name ELAINE Well # 4

CONTRACTOR: License # 5147  
Name Beredco, Inc.  
City/State Wichita, KS 67202

Ground surface elevation 3210 feet MSL

Well Drilled For: Well Class: Type Equipment:  
 Oil  Storage  Infield  Mud Rotary  
 Gas  Inj  Pool Ext.  Air Rotary  
 OWWO  Expl  Wildcat  Cable

Domestic well within 330 feet:  yes  no  
Municipal well within one mile:  yes  no

If OWWO: old well info as follows:

Depth to bottom of fresh water 160

Depth to bottom of usable water 1750

Surface pipe by Alternate: 1 2

Surface pipe planned to be set 325

Conductor pipe required None

Projected Total Depth 4800 feet

Formation Mississippian

I certify that well will comply with K.S.A. 55-101, et seq., plus eventually plugging hole to KCC specifications.

Date 10-6-88 Signature of Operator or Agent Evan C. Mayhew Title Engineer

For KCC Use:  
Conductor Pipe Required \_\_\_\_\_ feet; Minimum Surface Pipe Required 230' feet per Alt.  2

This Authorization Expires 4-13-89 Approved By LKM 10-13-88


EFFECTIVE DATE: 10-18-88

Must be filed with the K.C.C. five (5) days prior to commencing well  
This card void if drilling not started within six (6) months of date received by K.C.C.

**Important procedures to follow:**

1. Notify District office before setting surface casing.
2. Set surface casing by circulating cement to the top.
3. File completion forms ACO-1 with K.C.C. within 120 days of well spud date, following instructions on ACO-1, side 1, and including copies of wireline logs.
4. Notify District office 48 hours prior to old well workover or re-entry.
5. Prior to filing Intent, prepare a proposed plugging plan in case well is D & A, then obtain approval of plan when calling district office prior to setting surface pipe.
6. Submit plugging report (CP-4) to K.C.C. after plugging is completed.
7. Obtain an approved injection docket number before disposing of salt water.
8. Notify K.C.C. within 10 days when injection commences or terminates.
9. If an alternate 2 completion, cement in the production pipe from below any usable water to surface within 120 days of spud date.

**A Regular Section of Land  
1 Mile = 5,280 Ft.**

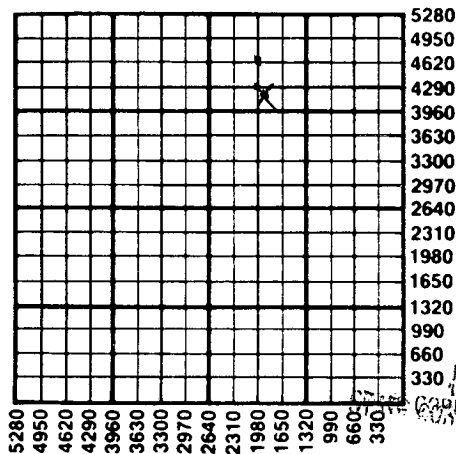

RECEIVED  
CORPORATION COMMISSION  
OCT 13 1988  
10-13-88  
CONSERVATION DIVISION  
Wichita, Kansas

State Corporation Commission of Kansas  
Conservation Division  
200 Colorado Derby Building  
Wichita, Kansas 67202-1212  
(316) 263-3238