

CARD MUST BE TYPED

State of Kansas

CARD MUST BE SIGNED

# NOTICE OF INTENTION TO DRILL

(see rules on reverse side)

Starting Date ..... May 30 1986  
month day year 3:02

API Number 15— 109-20, 423-0000

OPERATOR: License # 5364  
Name Beren Corporation  
Address 970 Fourth Financial Center  
City/State/Zip Wichita, Kansas 67202  
Contact Person Jerry Marcus  
Phone (316)265-3311

C SW NE Sec. 3 Twp. 12 S, Rg. 34  
3300 East  
1980 West  
Ft. from South Line of Section  
Ft. from East Line of Section

(Note: Locate well on Section Plat on reverse side)

CONTRACTOR: License # 5147  
Name BEREDCO  
City/State Wichita, Kansas 67202

Nearest lease or unit boundary line 660 feet  
County Logan  
Lease Name Elaine Well # 3

Well Drilled For: Well Class: Type Equipment:  
 Oil  SWD  Infield  Mud Rotary  
 Gas  Inj  Pool Ext.  Air Rotary  
 OWWO  Expl  Wildcat  Cable

Ground surface elevation 3215 feet MSL  
Domestic well within 330 feet:  yes  no  
Municipal well within one mile:  yes  no  
Depth to bottom of fresh water 150'  
Depth to bottom of usable water 1750'  
Surface pipe by Alternate: 1  2   
Surface pipe planned to be set 325'  
Conductor pipe required None  
Projected Total Depth 4800' feet

If OWWO: old well info as follows:

Operator .....  
Well Name .....  
Comp Date ..... Old Total Depth .....

Formation Mississippian  
Title Exploration Mgrs. *RCH*

I certify that well will comply with K.S.A. 55-101, et seq., plus eventually plugging hole to KCC specifications.

Date 5/28/86 Signature of Operator or Agent Title Exploration Mgrs.

For KCC Use:

Conductor Pipe Required ..... feet; Minimum Surface Pipe Required 300 feet per Alt. 4 ②

This Authorization Expires 11-28-86 Approved By 5-28-86 *R*


Must be filed with the K.C.C. five (5) days prior to commencing well  
This card void if drilling not started within six (6) months of date received by K.C.C.

**Important procedures to follow:**

**A Regular Section of Land  
1 Mile = 5,280 Ft.**

**RECEIVED**  
STATE CORPORATION COMMISSION  
MAY 28 8 10 AM '86  
CONSERVATION DIVISION  
Wichita, Kansas

1. Notify District office before setting surface casing.
2. Notify District office of surface casing by circulating cement to the top.
3. File completion forms ACO-1 with K.C.C. within 90 days of well completion, following instructions on ACO-1, side 1, and including copies of wireline logs.
4. Notify District office 48 hours prior to old well workover or re-entry.
5. Prior to filing Intent, prepare a proposed plugging plan in case well is D & A, then obtain approval of plan when calling district office prior to setting surface pipe.
6. Submit plugging report (CP-4) to K.C.C. after plugging is completed.
7. Obtain an approved injection docket number before disposing of salt water.
8. Notify K.C.C. within 10 days when injection commences or terminates.
9. If an alternate 2 completion, cement in the production pipe from below any usable water to surface within 120 days of spud date.

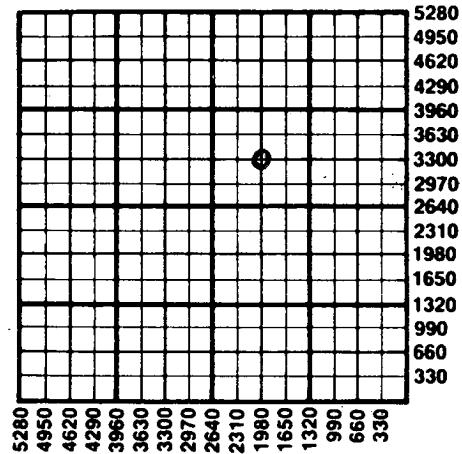

State Corporation Commission of Kansas  
Conservation Division  
200 Colorado Derby Building  
Wichita, Kansas 67202  
(316) 263-3238