

CARD MUST BE TYPED
CORRECTION

State of Kansas
NOTICE OF INTENTION TO DRILL
(see rules on reverse side)

CARD MUST BE SIGNED
CORRECTION

Starting Date:* 6-3-85.....
month day year

API Number 15- 109-20,374. ~~0000~~ **6-3-85**

OPERATOR: License # 9926.....

C. SE. SE. Sec. 20. Twp. 12-S, Rge. 33 East
(location) West

Name .. Boese Brothers.....

Address

City/State/Zip Monument, KS 67747

660..... Ft North from Southeast Corner of Section

Contact Person .. Ronald Boese.....

660..... Ft West from Southeast Corner of Section

Phone 913-672-3545.....

(Note: Locate well on Section Plat on reverse side)

CONTRACTOR: License # 5422.....

Nearest lease or unit boundary line 660..... feet.

* Name .. Abercrombie Drilling, Inc.....

County Logan.....

* City/State Wichita, KS 67202

Lease Name .. Bertrand..... Well# .. 3.....

Well Drilled For: Well Class: Type Equipment:

Domestic well within 330 feet: yes no

Oil Swd Infield Mud Rotary

Municipal well within one mile: yes no

Gas Inj Pool Ext. Air Rotary

* Depth to Bottom of fresh water 1350..... feet

OWWO Expl Wildcat Cable

* Lowest usable water formation Dakota.....

If OWWO: old well info as follows:

* Depth to Bottom of usable water 1700..... feet

Operator

Surface pipe by Alternate: 1 2

Well Name

* Surface pipe to be set 200..... feet

Comp Date Old Total Depth

Conductor pipe if any required N/A..... feet

Projected Total Depth 4750..... feet

* Ground surface elevation Approx. 3150 MSL

Projected Formation at TD Mississippian.....

This Authorization Expires 9-28-85.....

Expected Producing Formations Kansas City.....

Approved By 3-28-85.....

I certify that we will comply with K.S.A. 55-101, et seq., plus eventually plugging hole to K.C.C. specifications

1700' Surf.

PRODUCTION STRING WILL BE
CEMENTED IN PLACE
Date 6-3-85..... Signature of Operator or Agent

Jerry A. Langwehr
Title Exec. V.P. Abercrombie
Drilling, Inc. Form C-1 4/84

Must be filed with the K.C.C. five (5) days prior to commencing well
This card void if drilling not started within six (6) months of date received by K.C.C.
STATE CORPORATION COMMISSION

JUN 3 1985


Important procedures to follow:

A Regular Section of Land
1 Mile = 5,280 Ft.

CONSERVATION DIVISION
Wichita, Kansas

Notify District office before setting surface casing.

2. Set surface casing by circulating cement to the top.
3. File completion forms ACO-1 with K.C.C. within 90 days of well completion, following instructions on ACO-1, side 1, and including copies of wireline logs.
4. Notify District office 48 hours prior to old well workover or re-entry.
5. Prior to plugging, prepare a plugging plan, then obtain agreement from the appropriate district office for an approved plugging plan.
6. Submit plugging report (CP-4) to K.C.C. after plugging is completed.
7. Obtain an approved injection docket number before disposing of salt water.
8. Notify K.C.C. within 10 days when injection commences or terminates.
9. If an alternate 2 completion, cement in the production pipe from below any usable water to surface within 120 days of spud date.

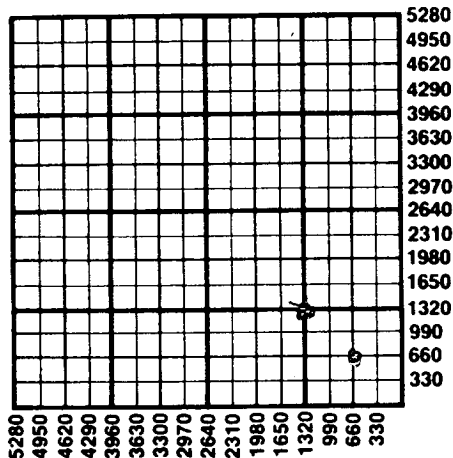

State Corporation Commission of Kansas
Conservation Division
200 Colorado Derby Building
Wichita, Kansas 67202
(316) 263-3238

CARD MUST BE TYPED

State of Kansas
NOTICE OF INTENTION TO DRILL
(see rules on reverse side)

CARD MUST BE SIGNED

Starting Date: 4-15-85
month day year

API Number 15- 109-20,374-0000

OPERATOR: License # 9926

.C. SE. SE ... Sec 20 . Twp 12. S, Rge 33. East West
(location)

Name BOESE BROTHERS
Address Monument Kansas 67747

660 Ft North from Southeast Corner of Section
660 Ft West from Southeast Corner of Section
(Note: Locate well on Section Plat on reverse side)

City/State/Zip

Contact Person Ronald Boese

Phone 913-672-3545

Nearest lease or unit boundary line 660 feet.

CONTRACTOR: License # UNKNOWN

County Logan Bertrand

Name

Lease Name Well# #3

City/State

Domestic well within 330 feet: yes no

Well Drilled For:	Well Class:	Type Equipment:
<input checked="" type="checkbox"/> Oil <input type="checkbox"/> Swd	<input type="checkbox"/> Infield	<input checked="" type="checkbox"/> Mud Rotary
<input type="checkbox"/> Gas <input type="checkbox"/> Inj	<input checked="" type="checkbox"/> Pool Ext.	<input type="checkbox"/> Air Rotary
<input type="checkbox"/> OWWO <input type="checkbox"/> Expl	<input type="checkbox"/> Wildcat	<input type="checkbox"/> Cable

Municipal well within one mile: yes no

If OWWO: old well info as follows:

Depth to Bottom of fresh water 200-1350 feet

Lowest usable water formation Dakota

Depth to Bottom of usable water 1500-1700 feet

Surface pipe by Alternate: 1 2

Surface pipe to be set 350-1700 feet

Conductor pipe if any required N/A

Ground surface elevation 3150Gr feet MSL

This Authorization Expires 9-28-85

Approved By 3-28-85 R

I certify that we will comply with K.S.A. 55-101, et seq., plus eventually plugging hole to K.C.C. specifications.

Date 4-25-85 Signature of Operator or Agent Ronald W. Boese

Title P.T.N.R.

Form C-1 4/84

MHC/KOHE 3-28-85

Must be filed with the K.C.C. five (5) days prior to commencing well
This card void if drilling not started within six (6) months of date received by K.C.C.

RECEIVED

STATE CORPORATION COMMISSION


MAR 28 1985
3-28-85

A Regular Section of Land
1 Mile = 5,280 Ft.

CONSERVATION DIVISION
Wichita, Kansas

Important procedures to follow:

1. Notify District office before setting surface casing.
2. Set surface casing by circulating cement to the top.
3. File completion forms ACO-1 with K.C.C. within 90 days of well completion, following instructions on ACO-1, side 1, and including copies of wireline logs.
4. Notify District office 48 hours prior to old well workover or re-entry.
5. Prior to plugging, prepare a plugging plan, then obtain agreement from the appropriate district office for an approved plugging plan.
6. Submit plugging report (CP-4) to K.C.C. after plugging is completed.
7. Obtain an approved injection docket number before disposing of salt water.
8. Notify K.C.C. within 10 days when injection commences or terminates.
9. If an alternate 2 completion, cement in the production pipe from below any usable water to surface within 120 days of spud date.

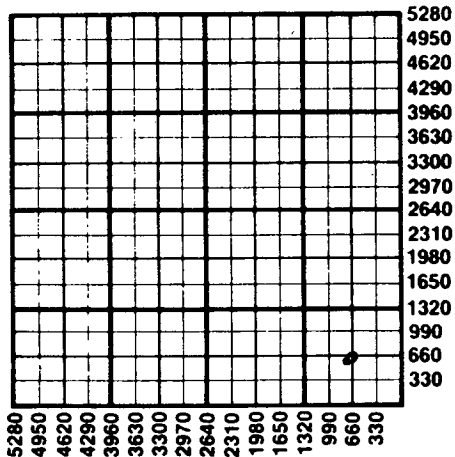

State Corporation Commission of Kansas
Conservation Division
200 Colorado Derby Building
Wichita, Kansas 67202
(316) 263-3238