

EFFECTIVE DATE: 3-20-95
DISTRICT # 4
SGA? Yes No

State of Kansas
NOTICE OF INTENTION TO DRILL

FORM MUST BE SIGNED
ALL BLANKS MUST BE FILLED

Must be approved by the K.C.C. five (5) days prior to commencing well.

Expected Spud Date 04 20 95
month day year

Spot C NW Sec 33 Twp 12 S, Rg 33 East
XX West

OPERATOR: License # 9860
Name: Castle Resources, Inc.
Address: 1200 E. 27th Suite C
City/State/Zip: Hays, Ks. 67601
Contact Person: Jerry Green
Phone: 913-625-5155

.....1320..... feet from South / North line of Section
.....1320..... feet from East / West line of Section
IS SECTION REGULAR IRREGULAR?

CONTRACTOR: License #: 30684
Name: Abercrombie RTD, Inc.

(NOTE: Locate well on the Section Plat on Reverse Side)
County: Logan

Well Drilled For: Well Class: Type Equipment:
 Oil ... Enh Rec ... Infield Mud Rotary
 Gas ... Storage Pool Ext. ... Air Rotary
 UWMO ... Disposal ... Wildcat ... Cable
 Seismic; ... # of Holes ... Other
 Other

Lease Name: Ahrens Well #: 2
Field Name:

If UWMO: old well information as follows:
Operator: N/A
Well Name:

Is this a Prorated/Spaced Field? ... yes no
Target Formation(s): LKC
Nearest lease or unit boundary: 1320'

* NOTE: change:
Directional, Deviated or Horizontal wellbore? ... yes no
If yes, true vertical depth: N/A
Bottom Hole Location:

Ground Surface Elevation: Unknown +3300' feet MSL
Water well within one-quarter mile: ... yes no
Public water supply well within one mile: ... yes no

Depth to bottom of fresh water: 100' 280'
Depth to bottom of usable water: 400' 1800'
Surface Pipe by Alternate: ... 1 2
* Length of Surface Pipe Planned to be set: 250' 300'

Length of Conductor pipe required: -0-
Projected Total Depth: 4800'
Formation at Total Depth: Mississippi

Water Source for Drilling Operations:
... well ... farm pond other

Will Cores Be Taken?: ... yes no
If yes, proposed zone:

WAS: API 1510920568

AFFIDAVIT IS: 15109205860000

The undersigned hereby affirms that the drilling, completion and eventual plugging of this well will comply with the Kansas Conservation Commission Act, Chapter 55-101, et. seq.

It is agreed that the following minimum requirements will be met:

1. Notify the appropriate district office prior to spudding of well;
2. A copy of the approved notice of intent to drill shall be posted on each drilling rig;
3. The minimum amount of surface pipe as specified below shall be set by circulating cement to the top; in all cases surface pipe shall be set through all unconsolidated materials plus a minimum of 20 feet into the underlying formation;
4. If the well is dry hole, an agreement between the operator and the district office on plug length and placement is necessary prior to plugging;
5. The appropriate district office will be notified before well is either plugged or production casing is cemented in;
6. IF AN ALTERNATE II COMPLETION, PRODUCTION PIPE SHALL BE CEMENTED FROM BELOW ANY USABLE WATER TO SURFACE WITHIN 120 DAYS OF SPUD DATE. IN ALL CASES, NOTIFY DISTRICT OFFICE PRIOR TO ANY CEMENTING.

I hereby certify that the statements made herein are true and to the best of my knowledge and belief.

Date: 03-14-95 Signature of Operator or Agent: [Signature] Title: Vice President

* FOR KCC USE:
API # 15- 109-205860000
Conductor pipe required NONE feet
Minimum surface pipe required 300 feet per Alt.
Approved by: DPW 3-15-95
This authorization expires: 9-15-95
(This authorization void if drilling not started within 6 months of effective date.)
Spud date: _____ Agent: _____

REMEMBER TO:

- File Drill Pit Application (form CDP-1) with Intent to Drill;
- File Completion Form ACO-1 within 120 days of spud date;
- File acreage attribution plat according to field proration orders;
- Notify appropriate district office 48 hours prior to workover or re-entry;
- Submit plugging report (CP-4) after plugging is completed;
- Obtain written approval before disposing or injecting salt water.

Mail to: KCC - Conservation Division, 130 S. Market - Room 2078, Wichita, Kansas 67202.

STATE RECEIVED
CONSERVATION COMMISSION
3-15-95
MAR 15 1995

33
12
33W

IN ALL CASES PLOT THE INTENDED WELL ON THE PLAT BELOW

PLAT OF ACREAGE ATTRIBUTABLE TO A WELL IN A PRORATED OR SPACED FIELD

If the intended well is in a prorated or spaced field, please fully complete this side of the form. If the intended well is in a prorated or spaced field complete the plat below showing that the well will be properly located in relationship to other wells producing from the common source of supply. Please show all the wells within 1 mile of the boundaries of the proposed acreage attribution unit for gas wells and within 1/2 mile of the boundaries of the proposed acreage attribution unit for oil wells.



API NO. 15- _____
 OPERATOR Castle Resources, Inc. LOCATION OF WELL: COUNTY Logan
 LEASE Ahrens 1320 feet from south/north line of section
 WELL NUMBER 2 1320 feet from east/west line of section
 FIELD _____ SECTION 33 TWP 12 RG 33W

NUMBER OF ACRES ATTRIBUTABLE TO WELL _____ IS SECTION X REGULAR or _____ IRREGULAR
 QTR/QTR/QTR OF ACREAGE _____ IF SECTION IS IRREGULAR, LOCATE WELL FROM NEAREST CORNER BOUNDARY.

Section corner used: _____ NE _____ NW _____ SE _____ SW

PLAT

(Show location of the well and shade attributable acreage for prorated or spaced wells.)
 (Show footage to the nearest lease or unit boundary line.)

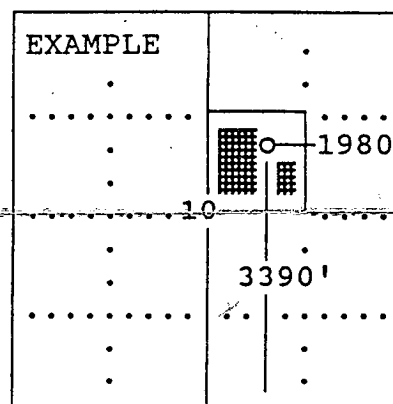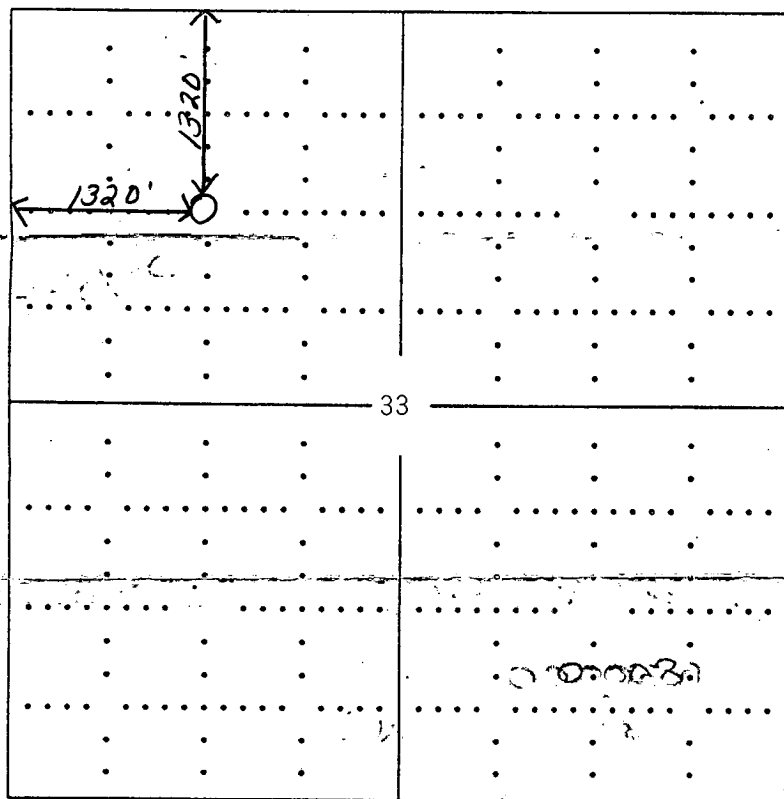

SEWARD CO.

In plotting the proposed location of the well, you must show:

- 1) The manner in which you are using the depicted plat by identifying section lines, i.e. 1 section, 1 section with 8 surrounding sections, 4 sections, etc.;
- 2) the distance of the proposed drilling location from the section's south/north and east/west; and
- 3) the distance to the nearest lease or unit boundary line.