

CARD MUST BE TYPED

State of Kansas

CARD MUST BE SIGNED

NOTICE OF INTENTION TO DRILL

(see rules on reverse side)

✓0

Starting Date April 24, 1988
month day year

API Number 15-109-20,459-0000

OPERATOR: License # 8541

NW NW NW 33 Twp. 12S S, Rg. 33 East
 West

Name Petex, Inc.

Address Route 2, Box 553

City/State/Zip Rogersville, MO 65742

Contact Person Larry Childress

Phone (417) 887-6289

CONTRACTOR: License # 5104

Name Blue Goose Drilling

City/State Great Bend, KS

Well Drilled For: Well Class: Type Equipment:

Oil SWD Infield Mud Rotary
 Gas Inj Pool Ext. Air Rotary
 OWWO Expl Wildcat Cable

If OWWO: old well info as follows:

Operator
Well Name
Comp Date Old Total Depth

4950 Sec. 33 Twp. 12S S, Rg. 33 East
4950 Ft. from South Line of Section
..... Ft. from East Line of Section

(Note: Locate well on Section Plat on reverse side)

Nearest lease or unit boundary line 330 feet
County Logan

Lease Name Anrens Well # 1

Ground surface elevation 3120 feet MSL

Domestic well within 330 feet: yes no

Municipal well within one mile: yes no

Depth to bottom of fresh water 160'

Depth to bottom of usable water 1700'

Surface pipe by Alternate: 1 2

Surface pipe planned to be set 210'

Conductor pipe required

Projected Total Depth 4700 feet

Formation Miss

I certify that well will comply with K.S.A. 55-101, et seq., plus eventually plugging hole to KCC specifications.

Date 4/8/88 Signature of Operator or Agent Larry Childress Title President

For KCC Use:

Conductor Pipe Required feet; Minimum Surface Pipe Required 200 feet per Alt. 2

This Authorization Expires 10-11-88 Approved By PCB 4-11-88


EFFECTIVE DATE: 4-16-88

Must be filed with the K.C.C. five (5) days prior to commencing well
This card void if drilling not started within six (6) months of date received by K.C.C.

Important procedures to follow:

1. Notify District office before setting surface casing.
2. Set surface casing by circulating cement to the top.
3. File completion forms ACO-1 with K.C.C. within 90 days of well completion, following instructions on ACO-1, side 1, and including copies of wireline logs.
4. Notify District office 48 hours prior to old well workover or re-entry.
5. Prior to filing Intent, prepare a proposed plugging plan in case well is D & A, then obtain approval of plan when calling district office prior to setting surface pipe.
6. Submit plugging report (CP-4) to K.C.C. after plugging is completed.
7. Obtain an approved injection docket number before disposing of salt water.
8. Notify K.C.C. within 10 days when injection commences or terminates.
9. If an alternate 2 completion, cement in the production pipe from below any usable water to surface within 120 days of spud date.

A Regular Section of Land 1 Mile = 5,280 Ft.

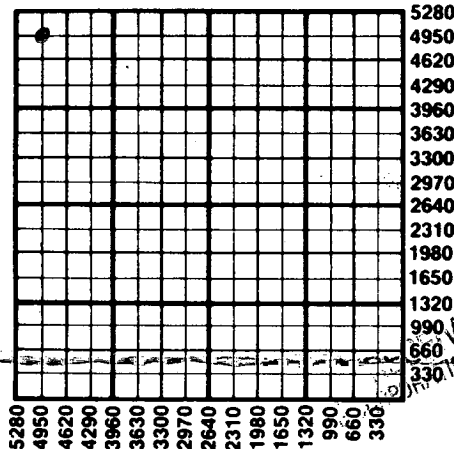

APR 11 1988
4-11-88
CONSERVATION DIVISION
Wichita, Kansas

State Corporation Commission of Kansas
Conservation Division
200 Colorado Derby Building
Wichita, Kansas 67202
(316) 263-3238