

CARD MUST BE TYPED

State of Kansas
NOTICE OF INTENTION TO DRILL
(see rules on reverse side)

CARD MUST BE SIGNED

Starting Date: December 1, 1985
month day year

API Number 15- 135-22,964-00-00

OPERATOR: License # 5046

...C. SE. NE ... Sec 27.. Twp 18. S, Rge 25.. ☐ East
(location) ☒ West

Name .. Raymond Oil Company, Inc.

Address .. P.O. Box 48788

City/State/Zip .. Wichita, Kansas..... 67201

Contact Person .. Pat Raymond

Phone ... 316/267-4214

...3300..... Ft North from Southeast Corner of Section

...660..... Ft West from Southeast Corner of Section

(Note: Locate well on Section Plat on reverse side)

CONTRACTOR: License # 5929

Name .. Duke Drilling Company Inc

City/State Wichita, Kansas

Nearest lease or unit boundary line 660 feet.

County Ness

Lease Name Dinges Well# 1

Domestic well within 330 feet : ☐ yes ☒ no

Municipal well within one mile : ☐ yes ☒ no

Well Drilled For: Well Class: Type Equipment:

☒ Oil ☐ Swd ☐ Infield ☒ Mud Rotary

☐ Gas ☐ Inj ☐ Pool Ext. ☐ Air Rotary

☐ OWWO ☐ Expl ☒ Wildcat ☐ Cable

If OWWO: old well info as follows:

Operator

Well Name'

Comp Date Old Total Depth

Projected Total Depth 4450 feet

Projected Formation at TD Mississippi

Expected Producing Formations ... Mississippi

Depth to Bottom of fresh water 150 feet

Lowest usable water formation Dakota

Depth to Bottom of usable water 750 feet

Surface pipe by Alternate : 1 ☐ 2 ☒

Surface pipe to be set 200 feet

Conductor pipe if any required None feet

Ground surface elevation .. Est. 2430 feet MSI.

This Authorization Expires 5-6-86

Approved By 11-6-85

I certify that we will comply with K.S.A. 55-101, et seq., plus eventually plugging hole to K.C.C. specifications.


Date 11-5-85 Signature of Operator or Agent Pat Raymond Title Vice President

Form C-1 4/84

Must be filed with the K.C.C. five (5) days prior to commencing well
This card void if drilling not started within six (6) months of date received by K.C.C.

Important procedures to follow :

**A Regular Section of Land
1 Mile = 5,280 Ft.**

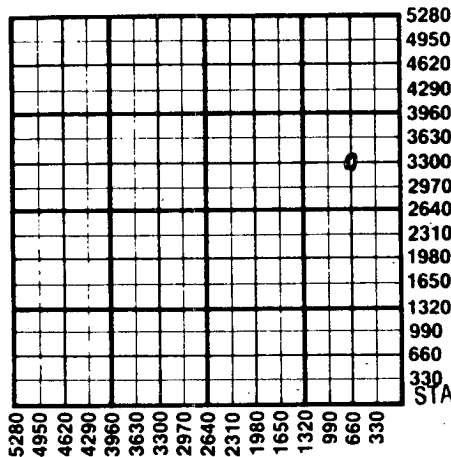

1. Notify District office before setting surface casing.
 2. Set surface casing by circulating cement to the top.
 3. File completion forms ACO-1 with K.C.C. within 90 days of well completion, following instructions on ACO-1, side 1, and including copies of wireline logs.
 4. Notify District office 48 hours prior to old well workover or re-entry.
 5. Prior to plugging, prepare a plugging plan, then obtain agreement from the appropriate district office for an approved plugging plan.
 6. Submit plugging report (CP-4) to K.C.C. after plugging is completed.
 7. Obtain an approved injection docket number before disposing of salt water.
 8. Notify K.C.C. within 10 days when injection commences or terminates.
- For alternate 2 completion, cement in the production pipe from below any usable water to surface within 120 days of spud date.

RECEIVED
NOV 6 1985
11-06-1985
CONSERVATION DIVISION
Wichita, Kansas

State Corporation Commission of Kansas
Conservation Division
200 Colorado Derby Building
Wichita, Kansas 67202
(316) 263-3238