

CARD MUST BE TYPED

State of Kansas
NOTICE OF INTENTION TO DRILL
(see rules on reverse side)

CARD MUST BE SIGNED

Starting Date: December 12, 1984
month day year

API Number 15- 135-22,738-00-00

OPERATOR: License # 6177
Name .. Foxfire Exploration, Inc.
Address P. O. Box 6360
City/State/Zip ... Los Osos, CA 93402
Contact Person D. C. Marchant
Phone (805) 528-6008

East
C. E./2 NE. NE. Sec. 30. Twp. 18. S, Rge 25. West
(location)

..... 4620 Ft North from Southeast Corner of Section
..... 330 Ft West from Southeast Corner of Section
(Note: Locate well on Section Plat on reverse side)

CONTRACTOR: License # 8430
Name .. Foxfire Drilling Co., Inc.
City/State P. O. Box 133, WaKeeney, KS. 67672

Nearest lease or unit boundary line 330 feet.
County Ness

Lease Name Tenney Well# A-2

Domestic well within 330 feet : yes no

Municipal well within one mile : yes no

Well Drilled For: Well Class: Type Equipment:
 Oil Swd Infield Mud Rotary
 Gas Inj Pool Ext. Air Rotary
 OWWO Expl Wildcat Cable

Depth to Bottom of fresh water 75 feet

Lowest usable water formation Dakota

Depth to Bottom of usable water 675-725 feet

Surface pipe by Alternate : 1 2

Surface pipe to be set 320 feet

Conductor pipe if any required N/A feet

Ground surface elevation 2484 feet MSL

This Authorization Expires 5-30-85

Approved By 11-30-84 *h.c.*

I certify that we will comply with K.S.A. 55-101, et seq., plus eventually plugging hole to K.C.C. specifications.

Date 11/26/84 Signature of Operator or Agent

D. C. Marchant
Title


Owner

MHC/NDHE 11/30/84
Form C-1 4/84

**Must be filed with the K.C.C. five (5) days prior to commencing well
This card void if drilling not started within six (6) months of date received by K.C.C.**

Important procedures to follow :

**A Regular Section of Land
1 Mile = 5,280 Ft.**

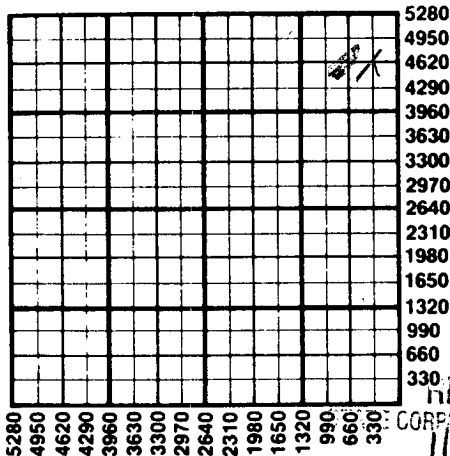

1. Notify District office before setting surface casing.
2. Set surface casing by circulating cement to the top.
3. File completion forms ACO-1 with K.C.C. within 90 days of well completion, following instructions on ACO-1, side 1, and including copies of wireline logs.
4. Notify District office 48 hours prior to old well workover or re-entry.
5. Prior to plugging, prepare a plugging plan, then obtain agreement from the appropriate district office for an approved plugging plan.
6. Submit plugging report (CP-4) to K.C.C. after plugging is completed.
7. Obtain an approved injection docket number before disposing of salt water.
8. Notify K.C.C. within 10 days when injection commences or terminates.
9. If an alternate 2 completion, cement in the production pipe from below any usable water to surface within 120 days of spud date.

RECEIVED
CORPORATION COMMISSION

11-30-1984
NOV 30 1984

CONSERVATION DIVISION
Wichita, Kansas

**State Corporation Commission of Kansas
Conservation Division
200 Colorado Derby Building
Wichita, Kansas 67202
(316) 263-3238**