

CARD MUST BE TYPED

State of Kansas

CARD MUST BE SIGNED

NOTICE OF INTENTION TO DRILL

(see rules on reverse side)

Starting Date August 2 1987
month day year

API Number 15- 109-20,444-0000 ✓

OPERATOR: License # 5285
Name The Dane G. Hansen Trust
Address P. O. Box 187
City/State/Zip Logan, Kansas 67546
Contact Person Dane G. Bales
Phone 913-689-4816

NE NW NW Sec. 1 Twp. 11 S, Rg. 33 East
X West
4950 Ft. from South Line of Section
4290 Ft. from East Line of Section

(Note: Locate well on Section Plat on reverse side)

CONTRACTOR: License # 5783
Name Galloway Drilling Co., Inc.
City/State Wichita, Kansas 67202

Nearest lease or unit boundary line 330 feet
County Logan
Lease Name Claude Well # 1

Well Drilled For: Well Class: Type Equipment:
 Oil SWD Infield Mud Rotary
 Gas Inj Pool Ext. Air Rotary
 OWWO Expl Wildcat Cable

Ground surface elevation est 3110 feet MSL
Domestic well within 330 feet: yes no
Municipal well within one mile: yes no
Depth to bottom of fresh water 230' 240'
Depth to bottom of usable water 1700

If OWWO: old well info as follows:
Operator
Well Name
Comp Date Old Total Depth

Surface pipe by Alternate: 1 2
Surface pipe planned to be set 280
Conductor pipe required
Projected Total Depth 4500 feet
Formation Mississippian

I certify that well will comply with K.S.A. 55-101, et seq., plus eventually plugging hole to KCC specifications.

Date 7/28/87 Signature of Operator or Agent Dan F. Bales Title Manager


For KCC Use:
Conductor Pipe Required _____ feet; Minimum Surface Pipe Required 260 feet per Alt. (2)
This Authorization Expires 1-29-88 Approved By P.H. 7-29-87

Must be filed with the K.C.C. five (5) days prior to commencing well
This card void if drilling not started within six (6) months of date received by K.C.C.

Important procedures to follow:

1. Notify District office before setting surface casing.
 2. Set surface casing by circulating cement to the top.
 3. File completion forms ACO-1 with K.C.C. within 90 days of well completion, following instructions on ACO-1, side 1, and including copies of wireline logs.
 4. Notify District office 48 hours prior to old well workover or re-entry.
 5. Prior to filing Intent, prepare a proposed plugging plan in case well is D & A, then obtain approval of plan when calling district office prior to setting surface pipe.
- Submit plugging report (CP-4) to K.C.C. after plugging is completed.
- Obtain an approved injection docket number before disposing of salt water.
- Notify K.C.C. within 10 days when injection commences or terminates.

A Regular Section of Land 1 Mile = 5,280 Ft.

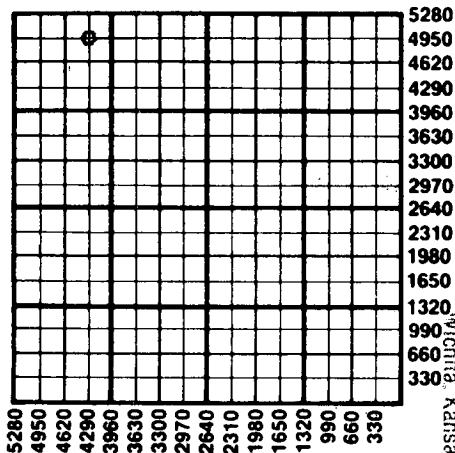

CONSERVATION DIVISION
Wichita, Kansas

JUL 29 1987

STATE CORPORATION COMMISSION RECEIVED

an alternate 2 completion, cement in the production pipe from below any usable water to surface within 120 days of spud date.

State Corporation Commission of Kansas
Conservation Division
200 Colorado Derby Building
Wichita, Kansas 67202
(316) 263-3238