

INSPECTION REPORT

15-051-21933-0000

LSINS
RECEIVED

DEC 11 2002
12-11-02
KCC WICHITA

Case# _____

<input type="checkbox"/>	Complaint
<input checked="" type="checkbox"/>	New Situation
<input checked="" type="checkbox"/>	Response to request
<input type="checkbox"/>	Follow-up

Date: December 10, 2002

Operator: Trans Pacific Oil Corporation

License: #9408

Address: Center Point at Main, 100 South Main Street, Suite 200

Location: NW/4 12-11-19W

City/St: Wichita, Kansas 67202-3734

Lease: Gladys

Phone: (316)262-3596

County: Ellis

Reason for investigation: Request from Amy Banks (K.C.C., Wichita)

Problem: Abandoned Well

Findings:

- > December 9, 2002: Gladys #5, located N/2 SW NW/4 12-11-19W Ellis County, Kansas. (Abandoned Well)

Photos: Yes

Action /recommendations:

- > The operator is in violation of K.A.R. 82-3-111, regarding the filing of an application with the conservation division requesting temporary abandonment.

Ed Schumacher P.I.R.T. II
(agent)

December 10, 2002

Ed Schumacher
(signature)

cc: file

ABANDONED WELL INFORMATION FORM
KCC HAYS DISTRICT OFFICE
=====

RECEIVED
DEC 11 2002
KCC WICHITA

Company Name: Trans Pacific Oil Corporation License #: 9408

Address: Center Point at Main, 100 S. Main Street, Suite 200

City/State: Wichita, Kansas 67202-3734

Phone: (316)262-3596

Lease: Gladys Well#: 5 Location: N/2 SW NW/4

Sec: 12 Twp: 11 Rg: 19W County: Ellis Well Type: Oil

Feet from South Line: 3630 Feet from East Line: 4620

Picture: YES X, NO Date: 12/09/02 Agent: Ed

Discussion: _____

Lease: Gladys Well#: 7 Location: NE NE NE/4

Sec: 12 Twp: 11 Rg: 19W County: Ellis Well Type: Oil

Feet from South Line: 4950 Feet from East Line: 330

Picture: YES X, NO Date: 12/09/02 Agent: Ed

Discussion: _____

Lease: Gladys Well#: 6 Location: E/2 E/2 SE/4

Sec: 12 Twp: 11 Rg: 19W County: Ellis Well Type: Oil

Feet from South Line: 1320 Feet from East Line: 330


Picture: YES X, NO Date: 12/09/02 Agent: Ed

Discussion: _____

December 10, 2002


TransPacific Oil Corporation #9408
Gladys Lease
NW/4 12-11-19W Ellis County, Kansas

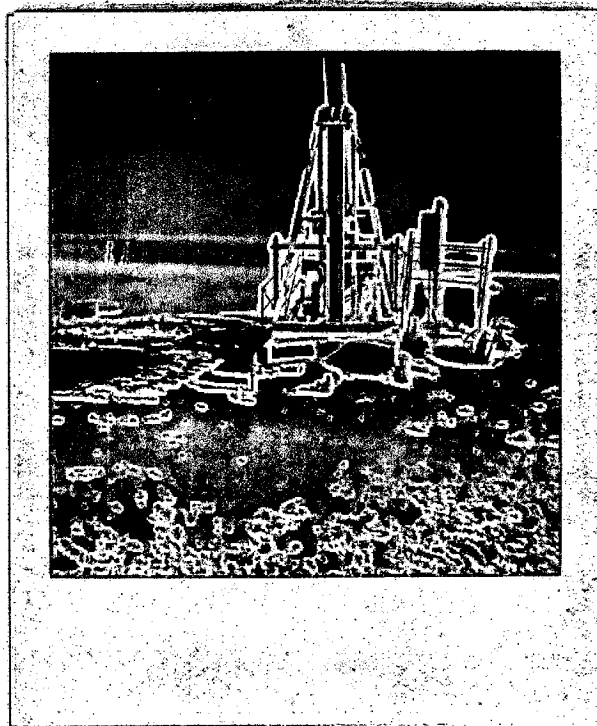



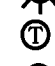

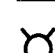
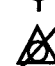



- < Lease inspection on December 09, 2002 to check for compliance with State Rules & Regulations regarding the Conservation of Crude Oil & Natural Gas.

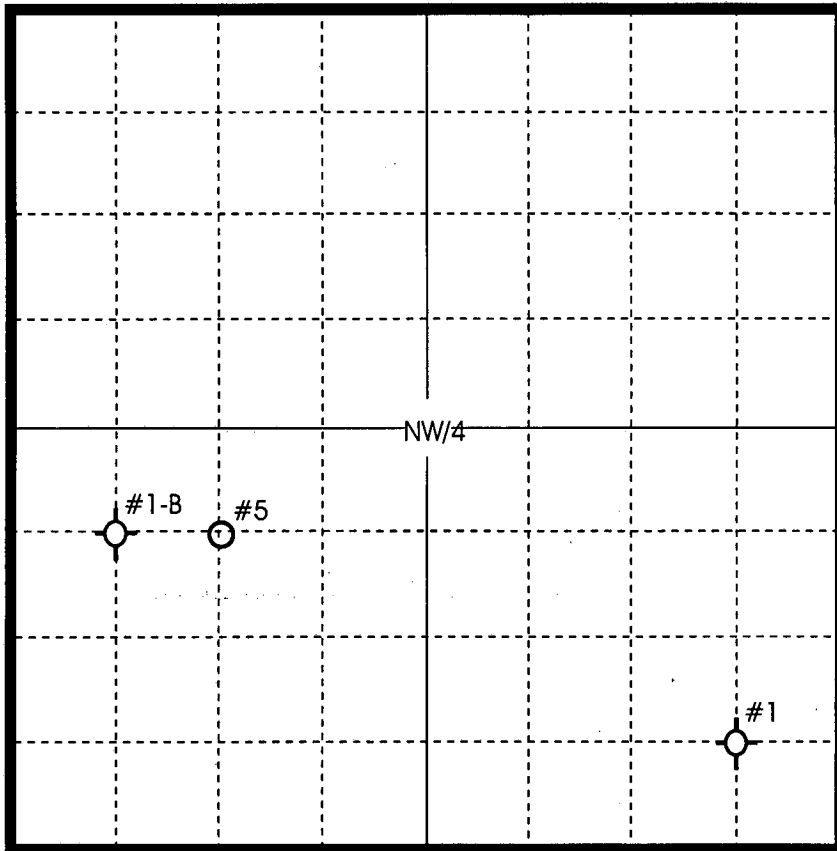

Gladys #5, located N/2 SW NW/4 12-11-19W
Ellis County, Kansas. (Abandoned Well)

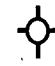Gladys Lease NW/4 12-11-19W Ellis County, Kansas



-  Dry Hole
-  Oil Well
-  Plugged Oil Well
-  Plugged SWD
-  Gas Well
-  Temporary Abandoned
-  Abandoned
-  Injection Well
-  SWD
-  Plugged Injection Well
-  Water Supply Well

Agent Ed Schumacher P.I.R.T. II

Date 12-09-02