

15-135-20998-00-00


FORM CP-4

STATE OF KANSAS  
STATE CORPORATION COMMISSION  
CONSERVATION DIVISION  
P. O. BOX 17027  
WICHITA, KANSAS 67217

WELL PLUGGING RECORD

Ness County, Sec. 19 Twp. 18S Rge. (E) 25 (W)

Location as "NE/CNW/SE" or footage from lines. C SE NW  
Lease Owner PETROLEUM, INC.  
Lease Name Whipple Well No. 1  
Office Address 800 R. H. Garvey Bldg., Wichita, Kansas 67202  
Character of Well (completed as Oil, Gas or Dry Hole)  
Date well completed 2-23 1975  
Application for plugging filed 2-23 1975  
Application for plugging approved 2-23 1975  
Plugging commenced 2-23 1975  
Plugging completed 2-23 1975  
Reason for abandonment of well or producing formation No commercial quantities of oil or gas encountered.  
If a producing well is abandoned, date of last production 19  
Was permission obtained from the Conservation Division or its agents before plugging was commenced? Yes

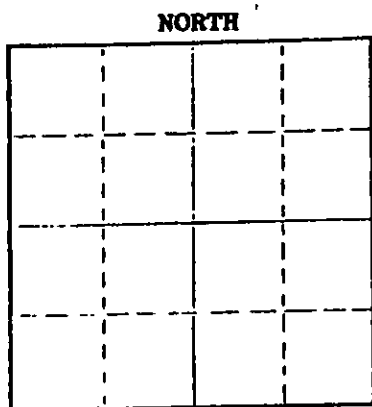

Locate well correctly on above Section Plat

Name of Conservation Agent who supervised plugging of this well Leo Massey  
Producing formation \_\_\_\_\_ Depth to top \_\_\_\_\_ Bottom \_\_\_\_\_ Total Depth of Well 4492 Feet  
Show depth and thickness of all water, oil and gas formations.

OIL, GAS OR WATER RECORDS

CASING RECORD

FORMATION	CONTENT	FROM	TO	SIZE	PUT IN	PULLED OUT
Surface Hole	Fluid	Surface	327	8-5/8"	319	None

Describe in detail the manner in which the well was plugged, indicating where the mud fluid was placed and the method or methods used in introducing it into the hole. If cement or other plugs were used, state the character of same and depth placed, from \_\_\_\_\_ feet to \_\_\_\_\_ feet for each plug set.

Fluid to 720', plug, 70 sx cement;  
Fluid to 240', plug, 20 sx cement;  
Fluid to 40', plug, 10 sx cement;

03-19-1975

(If additional description is necessary, use BACK of this sheet)

Name of Plugging Contractor D. N. B. DRILLING, INC.  
Address 701 First National Building  
Wichita, Kansas 67202  
STATE OF KANSAS COUNTY OF \_\_\_\_\_, ss.

JAMES L. DONELSON (employee of owner) or (owner or operator) of the above-described well, being first duly sworn on oath, says: That I have knowledge of the facts, statements, and matters herein contained and the log of the above-described well as filed and that the same are true and correct. So help me God.

(Signature) James L. Donelson  
710 First Nat'l Bldg., Wichita, Ks. 67202  
(Address)

SUBSCRIBED AND SWORN TO before me this 18 day of March 1975

My commission expires August 25, 1976

Ella Priess  
Ella Priess Notary Public

Ella Priess  
STATE NOTARY PUBLIC  
Sedgwick County, Kansas  
My Com. Expires Aug. 25, 1976

15-135-20998-00-00

PETROLEUM, INC.  
No. 1 Whipple  
C SE NW, Sec. 19-18S-25W  
Ness County, Kansas

DRILLERS' LOG

Commenced: 2-12-75  
Completed: 2-23-75

Elevation: 2537 K.B.

Surface: 319.42' of 8-5/8"  
cemented w/225 sx common  
cement, 28 Gal, 38 cc.  
2-13-75

FORMATION

DEPTH

Surface Hole	0 - 327
Shale & Sand	327 - 1201
Blaine Anhydrite	1201 - 1214
Shale, Sand & Red Bed	1214 - 1803
Anhydrite	1803 - 1837
Shale	1837 - 2305
Shale & Lime	2305 - 2482
Lime & Shale	2482 - 2690
Lime	2690 - 2827
Lime & Shale	2827 - 3840
Lime	3840 - 4492 RTD

03 19-1975

I do hereby certify that the foregoing statements are true and correct to the best of my knowledge and belief.

D N B DRILLING, INC.

*James L. Donelson*  
JAMES L. DONELSON

STATE OF KANSAS: ss:

Subscribed and sworn to before me, the undersigned, a Notary Public in and for said state, this 18th day of March, 1975.

My Commission Expires:  
August 25, 1976

*Ella Priess*  
Ella Priess, Notary Public

Notary Public  
Ella Priess  
Ness County, Kansas  
My Commission Expires August 25, 1976