


STATE OF KANSAS
STATE CORPORATION COMMISSION

WELL PLUGGING RECORD

Give All Information Completely
Make Required Affidavit
Mail or Deliver Report to
Conservation Division
State Corporation Comm.
245 North Water
Wichita, KS 67202

Ness County, Sec. 28 Twp. 18S Rge. 23W E/W
Location as "NE/CNW1SW1" or footage from lines
C SW NE

Lease Owner BEREXCO INC. - Beren Corporation
Lease Name Miner Well No. 1
Office Address 970 4th Fin. Ctr, Wichita, Kansas 67202
Character of Well (Completed as Oil, Gas or Dry Hole)

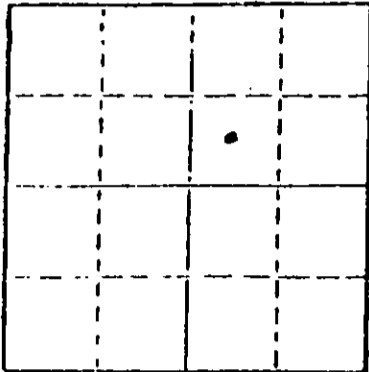

Locate well correctly on above
Section Plot

Dry Hole
Date Well completed October 11, 1982
Application for plugging filed October 11, 1982
Application for plugging approved October 11, 1982
Plugging commenced October 11, 1982
Plugging completed October 11, 1982
Reason for abandonment of well or producing formation
Dry Hole

If a producing well is abandoned, date of last production 19

Was permission obtained from the Conservation Division or its agents before plugging was commenced? Yes

Name of Conservation Agent who supervised plugging of this well Paul Luthi
Producing formation Depth to top Bottom Total Depth of Well
Show depth and thickness of all water, oil and gas formations.

OIL, GAS OR WATER RECORDS

CASING RECORD

FORMATION	CONTENT	FROM	TO	SIZE	PUT IN	PULLED OUT

Describe in detail the manner in which the well was plugged, indicating where the mud fluid was placed and the method or methods used in introducing it into the hold. If cement or other plugs were used, state the character of same and depth placed, from feet to feet for each plug set.

Plugged @ 840' w/ 35 sks
670' w/40 sks
Hulls & Plug 40' w/ 10 sks
10 sks Rat Hole
10 sks Mouse Hole
Cement used: 50-50 Pozmix, 2% Gel, 3% CC.

STATE CORPORATION COMMISSION
RECEIVED
OCT 21 1982
Wichita, Kansas

(If additional description is necessary, use BACK of this sheet)

Name of Plugging Contractor Sun Cementing

STATE OF Kansas COUNTY OF Sedgwick, ss.
Jerome D. Marcus (employee of owner) or (owner or operator)
of the above-described well, being first duly sworn on oath, says: That I have knowledge of the facts, statements, and matters herein contained and the log of the above-described well as filed and that the same are true and correct. So help me God.

(Signature) [Signature]
401 E. Douglas, Suite 402, Wichita, Kansas 67202 (Address)

SUBSCRIBED AND SWORN TO before me this 18th day of October, 1982

[Signature] Notary Public.

My commission expires 6-8-85

