

15-135-20767-00-00


STATE OF KANSAS
STATE CORPORATION COMMISSION

Form CP-4

Give All Information Completely
Make Required Affidavit
Mail or Deliver Report to:
Conservation Division
State Corporation Commission

WELL PLUGGING RECORD

P. O. Box 17027
Wichita, Kansas 67217
NORTH

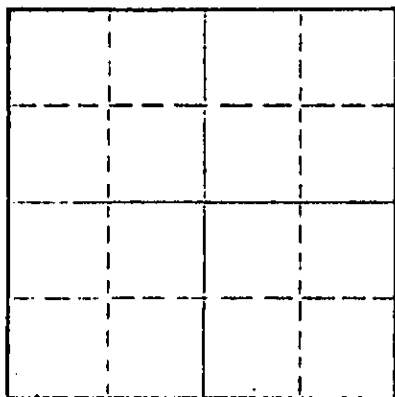

Locate well correctly on above
Section Plat

Ness County, Sec. 1 Twp. 18S Rge. (E) 25 (W)
Location as "NE/CNW/SE" or footage from lines C/SW SE
Lease Owner Strata Drilling, Inc. et al.
Lease Name Snyder Well No. 1
Office Address P. O. Box 355, Great Bend, Kansas 67530
Character of Well (completed as Oil, Gas or Dry Hole) Dry Hole
Date well completed June 27 19 73
Application for plugging filed June 27 19 73
Application for plugging approved June 27 19 73
Plugging commenced June 27 19 73
Plugging completed June 27 19 73
Reason for abandonment of well or producing formation Dry Hole

If a producing well is abandoned, date of last production 19
Was permission obtained from the Conservation Division or its agents before plugging was commenced? Yes

Name of Conservation Agent who supervised plugging of this well Leo Massey, Hays, Kansas
Producing formation Depth to top Bottom Total Depth of Well 4383 Feet
Show depth and thickness of all water, oil and gas formations.

OIL, GAS OR WATER RECORDS

CASING RECORD

FORMATION	CONTENT	FROM	TO	SIZE	PUT IN	PULLED OUT
	8-5/8"	0	286'			

Describe in detail the manner in which the well was plugged, indicating where the mud fluid was placed and the method or methods used in introducing it into the hole. If cement or other plugs were used, state the character of same and depth placed, from feet to feet for each plug set.

Plugged hole as follows: Plugged at 650' with 70 sacks of 50-50 pozmix and 6% gel; plugged at 240' with 20 sacks of 50-50 pozmix and 6% gel; plugged at 40' with 10 sacks of 50-50 pozmix and 6% gel. Plug down at 9:45 P. M. June 27, 1973.

RECEIVED
STATE CORPORATION COMMISSION

JUL 5 1973

CONSERVATION DIVISION
Wichita, Kansas


07-05-1973

(If additional description is necessary, use BACK of this sheet)
Name of Plugging Contractor Strata Drilling, Inc.
Address P. O. Box 355, Great Bend, Kansas 67530

STATE OF KANSAS, COUNTY OF BARTON, ss.
Charles W. Steincamp (employee of owner) or (owner) of the above-described well, being first duly sworn on oath, says: That I have knowledge of the facts, statements, and matters herein contained and the log of the above-described well as filed and that the same are true and correct. So help me God.

(Signature) Charles W. Steincamp
Charles W. Steincamp, President
P. O. Box 355, Great Bend, Kansas 67530
(Address)

Subscribed and sworn to before me this 28th day of June 19 73
Elaine H. Taylor
Notary Public.

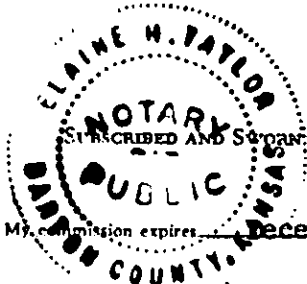

DRILLERS LOG

#1 Snyder

CASING RECORD: 280' of new 8-5/8" surface casing.	COMPANY: Strata Drilling, et al.	DESCRIPTION: C/SW SE Section 1-18S-25W Ness County, Kansas
TOTAL DEPTH: 4383'	CONTRACTOR: Strata Drilling, Inc.	ELEVATION: 2350' GR 2355' KB
	COMMENCED: June 17, 1973	
	COMPLETED: June 27, 1973	

D. & A.

<u>FORMATION</u>	<u>FROM</u>	<u>TO</u>	<u>REMARKS</u>	
Clay	0	40	Ran 280' of new 8-5/8" surface casing; set and cemented at 286' with 175 sacks of common cement, 2% gel and 3% C. C. Plug down at 9:45 P. M. June 17, 1973.	
Shale, Clay & Chalk	40	298		
Shale, Shells & Sand Streaks	298	369		
Shale, Red Bed w/Sand Streaks	369	1011		
Anhydrite	1011	1022		
Shale, Red Bed w/Sand Streaks	1022	1116		
Sand	1116	1360		
Shale w/Sand Streaks	1360	1400		
Shale	1400	1630		
Anhydrite	1630	1668		
Shale	1668	1924		
Shale, Sand & Lime	1924	2450		Six drill stem tests were run.
Lime & Shale	2450	4034		
Lime	4034	4042		
Lime & Shale	4042	4185		
Lime	4185	4228		
Lime & Shale	4228	4305		
Lime	4305	4383		

ROTARY TOTAL DEPTH: 4383'

D. & A.

No electric log was ran.

Plugged hole as follows: Plugged at 650' with 70 sacks of 50-50 pozmix and 6% gel; plugged at 240' with 20 sacks of 50-50 pozmix and 6% gel; plugged at 40' with 10 sacks of 50-50 pozmix and 6% gel. Plug down at 9:45 P. M. June 27, 1973.


07-05-1973
 RECEIVED
 STATE CORPORATION COMMISSION
 JUL 5 1973
 CONSERVATION DIVISION
 Wichita, Kansas

STATE OF KANSAS)
) ss.
 COUNTY OF BARTON)

I certify that this is a true and correct copy of the above log to the best of my knowledge.

STRATA DRILLING, INC.

Charles W. Steincamp
 Charles W. Steincamp, President

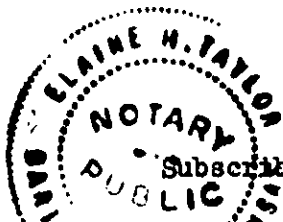

My Commission Expires:
 December 14, 1973

Elaine H. Taylor
 Elaine H. Taylor, Notary Public