


15-135-21640-00-00

STATE OF KANSAS
STATE CORPORATION COMMISSION

Form CP-4

Give All Information Completely
Make Required Affidavit
Mail or Deliver Report to:
Conservation Division
State Corporation Commission
P. O. Box 17027
Wichita, Kansas 67217

WELL PLUGGING RECORD

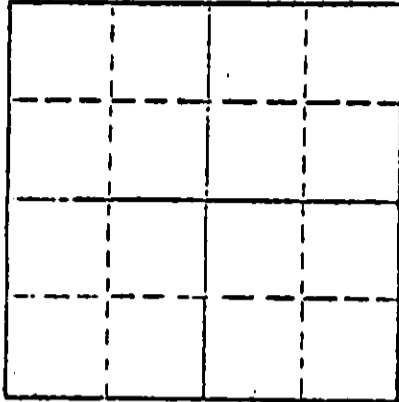

Locate well correctly on above
Section Plot

Ness County, Sec. 10 Twp. 18S Rge. 25W (E) (W)
Location as "NE/CNW/SW" or footage from lines NE NW SE
Lease Owner A. Scott Ritchie
Lease Name Moses-Hardman "B" Well No. #1
Office Address Suite 950, 125 North Market, Wichita, Kansas 67202
Character of Well (completed as Oil, Gas or Dry Hole) dry hole
Date well completed June 23, 1979
Application for plugging filed June 23, 1979
Application for plugging approved June 23, 1979
Plugging commenced June 23, 1979
Plugging completed June 23, 1979
Reason for abandonment of well or producing formation dry hole

If a producing well is abandoned, date of last production 19__
Was permission obtained from the Conservation Division or its agents before plugging was commenced? Yes

Name of Conservation Agent who supervised plugging of this well Marion Schmidt
Producing formation _____ Depth to top _____ Bottom _____ Total Depth of Well 4375' Feet
Show depth and thickness of all water, oil and gas formations.

OIL, GAS OR WATER RECORDS

CASING RECORD

FORMATION	CONTENT	FROM	TO	SIZE	PUT IN	PULLED OUT

Describe in detail the manner in which the well was plugged, indicating where the mud fluid was placed and the method or methods used in introducing it into the hole. If cement or other plugs were used, state the character of same and depth placed, from _____ feet to _____ feet for each plug set.

Hole plugged with 50-50 pozmix, 6% Gel, as follows: 70 sacks @ 600', 20 sacks @ 290', 10 sacks @ 40'. Plugging completed at 3:20 p.m., June 23, 1979

10-10-1979

(If additional description is necessary, use BACK of this sheet)

Name of Plugging Contractor Strata Drilling Company
Address P. O. Box 355, Great Bend, Kansas 67530


STATE OF KANSAS COUNTY OF BARTON ss.
Charles W. Steincamp (employee of owner) or (owner or operator) of the above-described well, being first duly sworn on oath, says: That I have knowledge of the facts, statements, and matters herein contained and the log of the above-described well as filed and that the same are true and correct. So help me God.

(Signature) Charles W. Steincamp
P. O. Box 355, Great Bend, Kansas 67530
(Address)

Subscribed and sworn to before me this 10th day of July, 1979.

My commission expires 3-28-80.

Loneita Barry Notary Public.

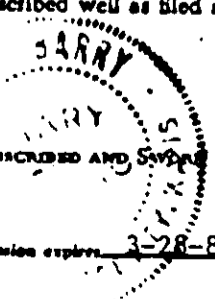

15-135-21640-00-00

D R I L L E R S L O G

#1 Moses-Hardman "B"

CASING RECORD:
7 jts. used 24#
8-5/8" surface
casing

COMPANY: A. Scott Ritchie
CONTRACTOR: Strata Drilling Company

DESCRIPTION: NE NW SE
Section 10-18S-25W
Ness County, Kansas

TOTAL ROTARY
DEPTH: 4375'

COMMENCED: June 15, 1979
COMPLETED: June 23, 1979

ELEVATION: 2377'

D & A

<u>FORMATION</u>	<u>FROM</u>	<u>TO</u>	<u>REMARKS</u>	
Surface soil, shale	0	315	Ran 296' used 24# 8-5/8" surface casing; set and cemented at 301' with 200 sacks common cement, 2% gel, 3% C.C. Cement circulated. Plug down at 6:40 p.m., June 15, 1979.	
Shale, shells	315	820		
Shale	820	1647		
Anhydrite	1647	1685		
Shale	1685	1850		
Lime and shale	1850	3900		
Lime	3900	4015		
Lime and shale	4015	4150		Ran 4 drill stem tests.
Lime	4150	4180		
Lime and shale	4180	4270		Ran a electric log.
Lime	4270	4357		
Lime and shale	4357	4375	Hole plugged with 50-50 pozmix, 6% gel, as follows: 70 sacks @ 600', 20 sacks @ 290', 10 sacks @ 40'. Plugging completed at 3:20 p.m., June 23, 1979.	

STATE OF KANSAS)
) ss
COUNTY OF BARTON)

10-10-1979
OCT 10 1979

I certify that this is a true and correct copy of the above log to the best of my knowledge.

STRATA DRILLING COMPANY

Charles W. Sturman

Sworn to and subscribed before me this 10th day of July, 1979.

My appointment expires 3-28-80.

Loneita Barry
Loneita Barry, Notary Public

