

15-135-20813-00-00

STATE OF KANSAS
STATE CORPORATION COMMISSION


Form CP-4

Give All Information Completely
Make Required Affidavit
Mail or Deliver Report to:
Conservation Division
State Corporation Commission
P. O. Box 17027
Wichita, Kansas 67217
NORTH

WELL PLUGGING RECORD

Ness County, Sec. 10 Twp. 18S Rge. 25W (E) (W)
C SW SW

Location as "NE/CNWSW" or footage from lines _____
Lease Owner Olympic Petroleum Company
Lease Name Moses Estate Trust Well No. 1
Office Address Parkland Plaza Bldg., 2121 S. Columbia Ave., Tulsa, Okla.
Character of Well (completed as Oil, Gas or Dry Hole) D & A
Date well completed December 21 19 73
Application for plugging filed December 21 19 73
Application for plugging approved December 21 19 73
Plugging commenced December 21 19 73
Plugging completed December 21 19 73
Reason for abandonment of well or producing formation D & A

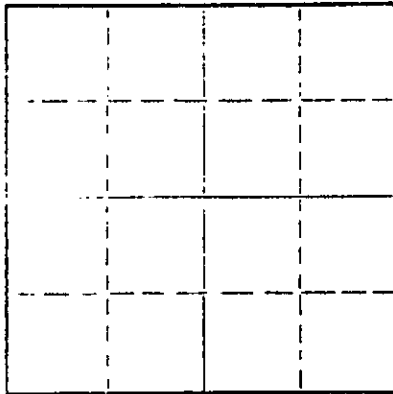

Locate well correctly on above
Section Plat

If a producing well is abandoned, date of last production _____ 19____
Was permission obtained from the Conservation Division or its agents before plugging was commenced? Yes

Name of Conservation Agent who supervised plugging of this well Mr. Leo F. Massey
Producing formation _____ Depth to top _____ Bottom _____ Total Depth of Well 4474 Feet
Show depth and thickness of all water, oil and gas formations.

OIL, GAS OR WATER RECORDS

CASING RECORD

FORMATION	CONTENT	FROM	TO	SIZE	PUT IN	PULLED OUT
				8-5/8"	328.50'	-0-

RECEIVED
STATE CORPORATION COMMISSION
JAN 13 1974
CONSERVATION DIVISION
Wichita, Kansas

0174-1974

Describe in detail the manner in which the well was plugged, indicating where the mud fluid was placed and the method or methods used in introducing it into the hole. If cement or other plugs were used, state the character of same and depth placed, from _____ feet to _____ feet for each plug set.

Plug hole - Mud to 700' & plug w/50 sx. cement
Mud to 300' & plug w/25 sx. cement
Plug @ 40' w/1/2 sk. hulls
10 sx. cement to bottom of cellar.

(If additional description is necessary, use BACK of this sheet)

Name of Plugging Contractor Red Tiger Drilling Company
Address 1720 Wichita Plaza, Wichita, Kansas 67202


STATE OF Kansas COUNTY OF Sedgwick, ss.
Linda H. Dickens (employee of owner) or (owner or operator) of the above-described well, being first duly sworn on oath, says: That I have knowledge of the facts, statements, and matters herein contained and the log of the above-described well as filed and that the same are true and correct. So help me God.

(Signature) Linda H. Dickens
1720 Wichita Plaza, Wichita, Kansas 67202
(Address)

Subscribed and sworn to before me this 26th day of December, 19 73

Linda C. Mowrey
Notary Public.

My commission expires May 24, 1977

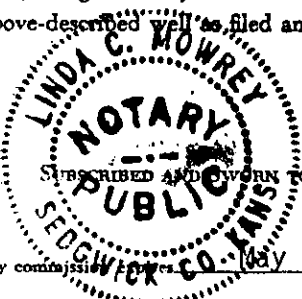

15-135-20813-00-00

DRILLERS LOG

No. 1 Moses Estate Trust

CASING RECORD:

8-5/8" @ 328.50'
w/210 sx. cement

COMPANY: Olympic Petroleum Co.

CONTRACTOR: Red Tiger Drilling Co.

COMMENCED: December 9, 1973

COMPLETED: December 21, 1973

DESCRIPTION:

C SW SW
10-18S-25W
Ness County, Kansas

ELEVATION:

<u>FORMATION</u>	<u>FROM</u>	<u>TO</u>	<u>REMARKS</u>
Rock	0	42	
Rock & Shale	42	78	
Shale	78	1746	
Anhydrite	1746	1788	
Shale	1788	1830	
Shale and Lime	1830	2421	
Lime	2421	2530	
Lime & Shale	2530	2830	
Lime	2830	3445	
Lime & Shale	3445	3715	
Lime	3715	4425	
Lime & Sand	4425	4463	
Lime	4463	4474	

RECEIVED
STATE CORPORATION COMMISSION
JAN 14 1974
CONSERVATION DIVISION
Oil and Gas

01-14-1974

I certify that this is a true and correct copy of the above log to the best of my knowledge.

RED TIGER DRILLING COMPANY

Linda H. Dickens
Linda H. Dickens

Subscribed and sworn to before me this 26th day of December, 1973.

Linda C. Mourey
Notary Public

My Commission Expires:

May 24, 1977

