

STATE OF KANSAS  
STATE CORPORATION COMMISSION

WELL PLUGGING RECORD

Give All Information Completely  
Make Required Affidavit  
Mail or Deliver Report to  
Conservation Division  
State Corporation Comm.  
245 North Water  
Wichita, KS 67202

Ness County, Sec. 15 Twp. 18 Rge. 26 E/W  
Location as "NE/CNW $\frac{1}{4}$ SW $\frac{1}{4}$ " or footage from lines  
C SE SW

Lease Owner Vincent Oil Corporation  
Lease Name Walter Well No. 1  
Office Address 230 O. W. Garvey Building, Wichita 67202  
Character of Well (Completed as Oil, Gas or Dry Hole) Dry Hole


Date Well completed 7/28/80 19  
Application for plugging filed 7/28/80 19  
Application for plugging approved 7/28/80 19  
Plugging commenced 7/28/80 19  
Plugging completed 7/28/80 6:15 a.m. 19  
Reason for abandonment of well or producing formation

If a producing well is abandoned, date of last production 19

Was permission obtained from the Conservation Division or its agents before plugging was commenced? Yes

Name of Conservation Agent who supervised plugging of this well Marion Schmidt  
Producing formation Depth to top Bottom Total Depth of Well

Show depth and thickness of all water, oil and gas formations. RTD 4576'

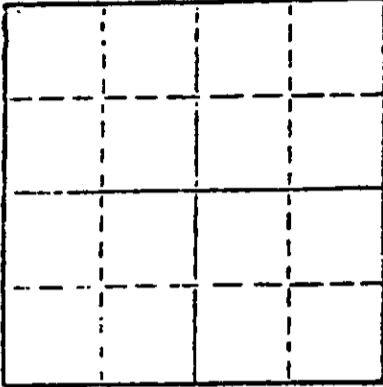

Locate well correctly on above Section Plot

OIL, GAS OR WATER RECORDS

CASING RECORD

FORMATION	CONTENT	FROM	TO	SIZE	PUT IN	PULLED OUT
	Surface	0	362'	8-5/8"	yes	no

Describe in detail the manner in which the well was plugged, indicating where the mud fluid was placed and the method or methods used in introducing it into the hold. If cement or other plugs were used, state the character of same and depth placed, from \_\_\_\_\_ feet to \_\_\_\_\_ feet for each plug set.

- 1st plug @ 1170' with 70 sacks
- 2nd plug @ 341' with 25 sacks
- 3rd plug @ 40' with 10 sacks
- 5 sacks in rathole
- Job Complete 6:15 a.m. 7/28/80

(If additional description is necessary, use BACK of this sheet)

Name of Plugging Contractor Slawson Drilling Company, Inc.


STATE OF Kansas COUNTY OF Sedgwick, ss.  
James C. Remsberg, Slawson Drilling Co., Inc. (employee of owner) or (owner or operator of the above-described well, being first duly sworn on oath, says: That I have knowledge of the facts, statements, and matters herein contained and the log of the above-described well as filed and that the same are true and correct. So help me God.

(Signature) James C. Remsberg  
James C. Remsberg  
800 Douglas Building, Wichita, Kansas 67202  
(Address)

SUBSCRIBED AND SWORN TO before me this 13 day of August, 19 80

Mary Lou Taylor RECEIVED  
Mary Lou Taylor Notary Public.  
STATE CORPORATION COMMISSION

My commission expires January 17, 1981

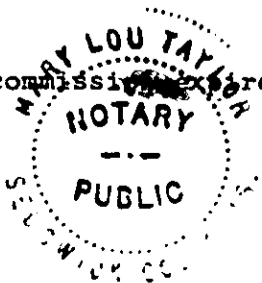

AUG 15 1980

CONSERVATION DIVISION  
Wichita, Kansas

DRILLERS LOG

OPERATOR: Vincent Oil Corporation  
 230 O. W. Garvey Building  
 Wichita, Kansas 67202

WELL NAME: Walter #1  
 C SE SW Sec. 15-18S-26W  
 Ness County, Kansas

CONTRACTOR: Slawson Drilling Company, Inc.  
 200 Douglas Building  
 Wichita, Kansas 67202

COMMENCED: 7/18/80

COMPLETED: 7/28/80

RTD: 4576'

SURFACE CASING: 8-5/8" set at 362' with 260 sx cement

0' to 366' 12 1/2" Surface Hole  
 366' to 3347' Shale  
 3347' to 3650' Lime & Shale  
 3650' to 3768' Shale & Lime  
 3768' to 3777' Lime  
 3777' to 3967' Shale & Lime  
 3967' to 4196' Lime & Shale  
 4196' to 4291' Shale & Lime  
 4291' to 4576' Lime  
 4576' Mississippian  
 RTD 4576'

STATE OF KANSAS

COUNTY OF SEDGWICK

I, James C. Remsberg, of the Slawson Drilling Company, Inc. hereby state the above is an accurate copy of the Walter #1 log for Vincent Oil Corporation.

*James C. Remsberg*  
 James C. Remsberg

Subscribed and sworn to me this 13th day of August, 1980

*Mary Lou Taylor*  
 Mary Lou Taylor

My commission expires January 17, 1981

RECEIVED  
 STATE CORPORATION COMMISSION  
 AUG 15 1980  
 CONSERVATION DIVISION  
 Wichita, Kansas

