

STATE OF KANSAS
STATE CORPORATION COMMISSION
200 Colorado Derby Building
Wichita, Kansas 67202

WELL PLUGGING RECORD
K.A.R.-82-3-117

API NUMBER 15-135-22,121 ²²⁴²¹⁻
LEASE NAME Stutz ⁰⁰⁰⁰

TYPE OR PRINT
NOTICE: Fill out completely
and return to Cons. Div.
office within 30 days.

WELL NUMBER "H" #1
SPOT LOCATION SW NW NE
SEC. 12 TWP. 17 RGE. 26 (E) or (W)
COUNTY Ness
Date Well Completed _____
Plugging Commenced 6-4-84
Plugging Completed 6-8-84

LEASE OPERATOR Pickrell Drilling Company
ADDRESS Box 1303, Great Bend, Ks. 67530
PHONE # (316-793-5742) OPERATORS LICENSE NO. 5123

Character of Well oil
(Oil, Gas, D&A, SWD, Input, Water Supply Well)

Did you notify the KCC/KDHE Joint District Office prior to plugging this well? Yes

Which KCC/KDHE Joint Office did you notify? One

Is ACO-1 filed? _____ If not, is well log attached? With application

Producing formation _____ Depth to top _____ bottom _____ T.D. 4,545'

Show depth and thickness of all water, oil and gas formations.

OIL, GAS OR WATER RECORDS

CASING RECORD

Formation	Content	From	To	Size	Put in	Pulled out
				8-5/8"	248'	None
				4-1/2"	4,532'	2,473.40'

Describe in detail the manner in which the well was plugged, indicating where the mud fluid was placed and the method or methods used in introducing it into the hole. If cement or other plugs were used state, the character of, same and depth placed, from feet to feet each set. Dumped sand to 4410' and 4 sacks cement. Shot casing at 3,500' and 3,000' and 2500'. Pulled 81 joints of 4-1/2" casing. Squeezed well with 3 sacks hulls, 15 sacks gel, 50 sacks cement, 10 sacks gel, 1 sack hulls, released plug and pumped 125 sacks 50/50 pozmix cement with 6% added gel and 3% calcium chloride.

Name of Plugging Contractor Rockhold Engineering, Inc. License No. 5111
Address Box 698, Great Bend, Kansas 67530

STATE OF Kansas COUNTY OF Barton, ss.

James W. Rockhold (employee of operator) or (operator) of above-described well, being first duly sworn on oath, says: That I have knowledge of the facts, statements, and matters herein contained and the log of the above-described well ^{RECEIVED} and that the same are true and correct, so help me God.

STATE CORPORATION COMMISSION

(Signature) James W. Rockhold
James W. Rockhold
(Address) Box 698, Great Bend, Ks. 67530

JUN 12 1984

CONSERVATION DIVISION
SUBSCRIBED AND SWORN TO before me this 11th day of June, 1984
Wichita, Kansas


STATE NOTARY PUBLIC
KANSAS
IONA M. LEATHERMAN
Barton County, Kansas
My Appt. Exp. 9-26-87

Iona M. Leatherman
Notary Public

My Commission expires:

STUTZ H-1

JW NW NE Sec 12-175-26 W
Ness County, KS.

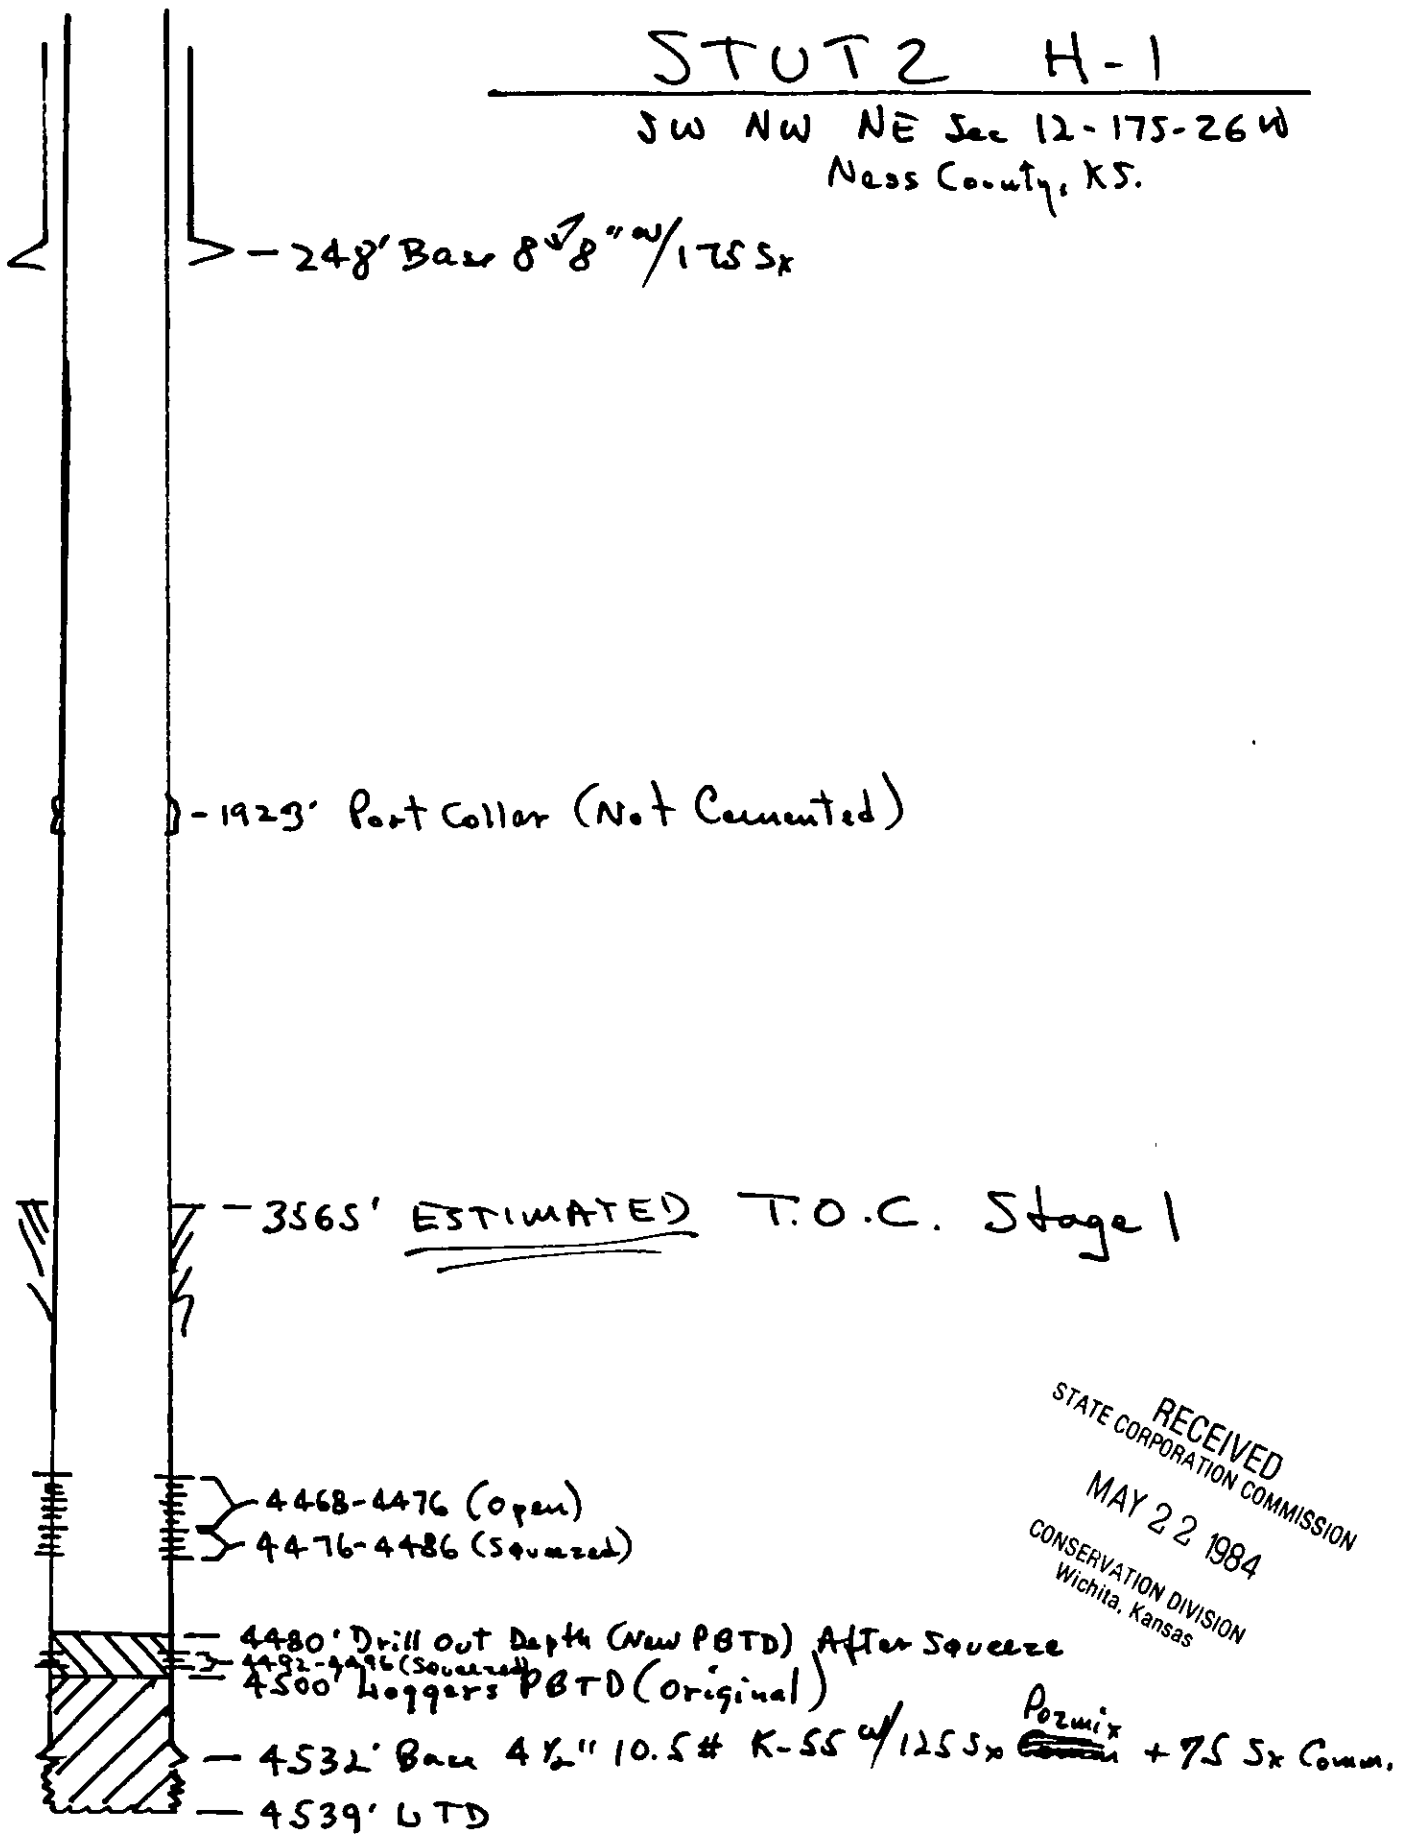

- 248' Base 8 1/8" w/ 125 Sx

- 1923' Port Collar (Not Cemented)

- 3565' ESTIMATED T.O.C. Stage 1

4468-4476 (Open)
4476-4486 (Squeezed)

- 4480' Drill out Depth (New PBD) After Squeeze
- 4492-4496 (Squeezed)
- 4500' Loggers PBD (Original)

- 4532' Base 4 1/2" 10.5# K-55 w/ 125 Sx Pozmix + 75 Sx Comm.
- 4539' LTD

RECEIVED
STATE CORPORATION COMMISSION
MAY 22 1984
CONSERVATION DIVISION
Wichita, Kansas