

WELL PLUGGING RECORD

Give All Information Completely
Make Required Affidavit

COUNTY Ness SEC. 1 TWP. 20S RGE. 21W ~~21E~~
Location as in quarters or footage from lines:
C NW NE

		+	

Lease Owner American Energies Corporation
Lease Name Coddington Well No. 1
Office Address 575 Fourth Financial Center, Wichita, KS 67202
Character of Well (Completed as Oil, Gas or Dry Hole): Dry Hole
Date Well Completed July 1, 1981
Application for plugging filed July 1, 1981
Plugging commenced July 1, 1981
Plugging completed July 1, 1981
Reason for abandonment of well or producing formation _____

Locate Well
correctly on above
Section Platt.

Was permission obtained from the Conservation Division or it's
Agent's before plugging was commenced? yes

Name of Conservation Agent who supervised plugging of this well Marion Schmidt
Producing formation _____ Depth to top _____ bottom _____ T.D. 4465'
Show depth and thickness of all water, oil and gas formations.

OIL, GAS OR WATER RECORDS

Casing Record

Formation	Content	From	To	Size	Put in	Pulled Out
surface hole	shale	surface	495'	8-5/8"	491'	none
	cemented with 350 sx 60/40 posmix, 2% gel, 3% cc, plug down at 9 a.m. 6-26-81 by Sun.					


Describe in detail the manner in which the well was plugged, indicating where the mud fluid was placed and the method or methods used in introducing it into the hold. If cement or other plugs were used, state the character of same and depth placed, from _____ feet to _____ feet for each plug set.

Plugged as follows:
65 sx @ 780'
30 sx @ 270'
10 sx @ 40' & 5 sx in rat hole; job completed @ 6 p.m. 7-1-81 by Sun.

(If additional description is necessary, use BACK of this sheet)
Name of Plugging Contractor Husky Drilling Co., Inc.

STATE OF KANSAS COUNTY OF SEDGWICK, ss.
Jon T. Williams, Jr. (employee of owner) or (owner or operator) of the above-described well, being first duly sworn on oath, says: That he has knowledge of the facts, statements, and matters herein contained and the log of the above-described well as filed and that the same are true and correct. So help me God.

(Signature) [Signature]
HUSKY DRILLING CO., INC.
200 E. First Suite 500 Wichita, KS 67202
(Address)

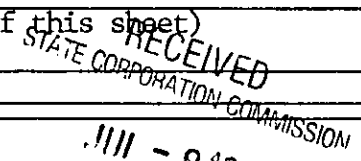

WITNESSED AND SWORN TO before me this 7th day of July, 19 81
Geraldine Stewart
Geraldine Stewart Notary Public.
My Commission expires: January 14, 1985



15-135-2244-0000



200 E. First, Suite 500
~~800 Biting Blvd~~
Wichita, Kansas 67202
Phone 316 - 263-7904
Mobile Phone 316 - 793-7859 Unit 7070

July 7, 1981

WELL LOG-----Coddington No. 1
Located: C NW NE of Sec. 1-20S-21W, Ness County, Kansas

OPERATOR: American Energies Corporation
ROTARY CONTRACTOR: Husky Drilling Co., Inc.

COMMENCED: June 25, 1981
COMPLETED: July 1, 1981

Rotary Total Depth: 4465'

LOG

0 - 255	Soil, part rock & sand
255 - 420	Shale
420 - 465	Sand
465 - 700	Shale
700 - 855	Red Bed
855 - 1115	Sand
1115 - 1265	Shale & shells
1265 - 1480	Red Bed & Shale
1480 - 1509	Anhydrite
1509 - 2350	Shale & shells
2350 - 3930	Shale & lime
3930 - 4110	Lime
4110 - 4427	Lime & shale
4427 - 4465	Chert


CASING RECORD

Ran 12 jts., new 23#, 8-5/8"
tallied 484.74 set @ 491'KB w/
350 sx 60/40 pos, 2%gel, 3%cc,
plug down at 9 a.m. 6-26-81
by Sun. Cement did circulate.

Plugged & Abandoned 7-1-81.

I certify the above to be a true and correct copy of the driller's log to the best of my knowledge and belief.

HUSKY DRILLING CO., INC.

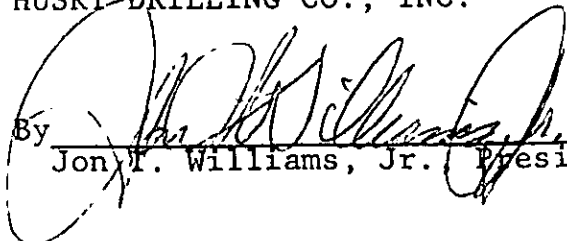By 
Jon F. Williams, Jr. President