

STATE OF KANSAS  
STATE CORPORATION COMMISSION

WELL PLUGGING RECORD


OR

FORMATION PLUGGING RECORD

Strike out upper line  
when reporting plug-  
ging off formations.

Give All Information Completely  
Make Required Affidavit  
Mail or Deliver Report to:  
Conservation Division  
State Corporation Commission  
800 Bittling Building  
Wichita, Kansas

NORTH

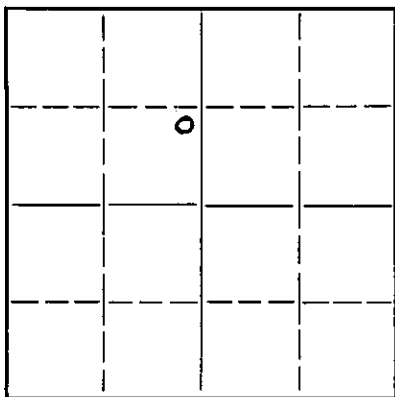

Locate well correctly on above  
Section Plat

Ellis County, Sec. 19 Twp. 11S Rge. 18W (E) (W)  
Location as "NE 1/4 NW 1/4 SW 1/4" or footage from lines NE 1/2 SE 1/2 NW 1/2  
Lease Owner Continental Oil Co.  
Lease Name John Hancock Life Insurance Co. Well No. 1  
Office Address Ponca City, Oklahoma  
Character of Well (completed as Oil, Gas or Dry Hole) Stratigraphic Test  
Date well completed October 27, 1942  
Application for plugging filed October 27, 1942  
Application for plugging approved October 27, 1942  
Plugging commenced October 27, 1942  
Plugging completed October 28, 1942  
Reason for abandonment of well or producing formation

If a producing well is abandoned, date of last production 19  
Was permission obtained from the Conservation Division or its agents before plugging was com-  
menced? Yes

Name of Conservation Agent who supervised plugging of this well Mr. C. T. Alexander  
Producing formation Depth to top Bottom Total Depth of Well 3550 Feet  
Show depth and thickness of all water, oil and gas formations.

OIL, GAS OR WATER RECORDS

CASING RECORD

Formation	Content	From	To	Size	Put In	Pulled Out
				8 5/8"	109 ft.	none

Describe in detail the manner in which the well was plugged, indicating where the mud fluid was placed and the method or methods used in introducing it into the hold. If cement or other plugs were used, state the character of same and depth placed, from feet to feet for each plug set.

The hole was filled with heavy mud by circulating every 500 feet from the bottom.  
The hole was bridged at 25 ft. with a wooden plug, rock and burlap and then fifteen sacks of cement placed on top thru the drill pipe. The hole was bridged again at 26 feet with a wooden plug, rock and burlap and cemented to the top of the surface pipe.

(If additional description is necessary, use BACK of this sheet)

Correspondence regarding this well should be addressed to J. George Klein  
Address Box 6 Plainville, Kansas

STATE OF Kansas, COUNTY OF Reels, SS.  
J. George Klein (employee of owner) or (owner or operator) of the above-described well,  
being first duly sworn on oath, says: That I have knowledge of the facts, statements, and matters herein contained and the log of the above-described well as filed and that the same are true and correct. So help me God.

(Signature) J. George Klein  
Plainville, Kansas (Address)

SUBSCRIBED AND SWORN to before me this 7 day of November 1944 11-06-42

My commission expires June 7 1944 Edith Vanhook Notary Public

