

STATE OF KANSAS
STATE CORPORATION COMMISSION


WELL PLUGGING RECORD

OR
FORMATION PLUGGING RECORD

Strike out upper line
when reporting plugging
of formations.

Give All Information Completely
Make Required Affidavit
Mail or Deliver Report to:
Conservation Division
State Corporation Commission
800 Bitting Building
Wichita, Kansas

Ellis County. Sec. 19 Twp. 11S Rge. (E) 18 (W)
Location as "NE $\frac{1}{4}$ NW $\frac{1}{4}$ SW $\frac{1}{4}$ " or footage from lines 330' FSL & 330' FEL NE $\frac{1}{4}$ /
Lease Owner Skelly Oil Company
Lease Name Cleve D. Miller Well No. 1
Office Address Box 1650, Tulsa, Oklahoma
Character of Well (completed as Oil, Gas or Dry Hole) Dry Hole
Date well completed August 22, 19 47
Application for plugging filed August 25, 19 47
Application for plugging approved August 26, 19 47
Plugging commenced August 23, 19 47
Plugging completed August 23, 19 47
Reason for abandonment of well or producing formation Dry Hole

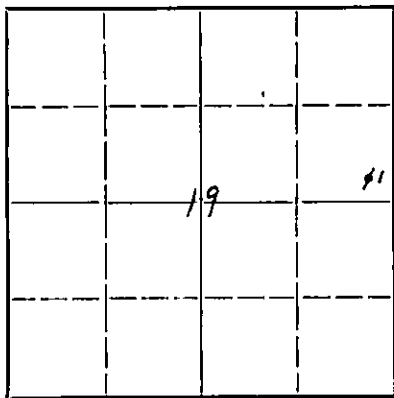

Locate well correctly on above
Section Plat

If a producing well is abandoned, date of last production 19
Was permission obtained from the Conservation Division or its agents before plugging was commenced? Yes (Verbally)

Name of Conservation Agent who supervised plugging of this well C. D. Stough
Producing formation None Depth to top Bottom Total Depth of Well 3670 Feet
Show depth and thickness of all water, oil and gas formations.


OIL, GAS OR WATER RECORDS

CASING RECORD

Formation	Content	From	To	OD Size	Put In	Pulled Out
Arbuckle Lime	Dry	3640'		13-3/8"	152'0"	None
				8-5/8"	1399'3"	None

Describe in detail the manner in which the well was plugged, indicating where the mud fluid was placed and the method or methods used in introducing it into the hold. If cement or other plugs were used, state the character of same and depth placed, from feet to feet for each plug set.

30 sacks of cement 3670' to 3580'
Mud laden fluid 3580' to 1362'
Wood plug 1362'
20 sacks of cement 1362' to 1302'
Mud laden fluid 1302' to 155'
Wood plug 155'
20 sacks of cement 155' to 95'
Mud laden fluid 95' to 40'
Wood plug 40'
20 sacks of cement 40' to 6'
Surface soil 6' to 0'

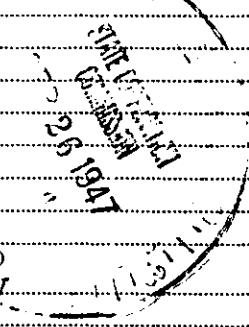

(If additional description is necessary, use BACK of this sheet)

Correspondence regarding this well should be addressed to Skelly Oil Company
Address Box 391, Hutchinson, Kansas


STATE OF Kansas, COUNTY OF Reno, ss.
H. E. Wamsley (employee of owner) of Skelly Oil Company of the above-described well,
being first duly sworn on oath, says: That I have knowledge of the facts, statements, and matters herein contained and the log of the above-described well as filed and that the same are true and correct. So help me God.


(Signature) [Signature]
Box 391, Hutchinson, Kansas (Address)

SUBSCRIBED AND SWORN to before me this 25th day of September, 19 47

My commission expires April 7, 1951

[Signature] Notary Public.

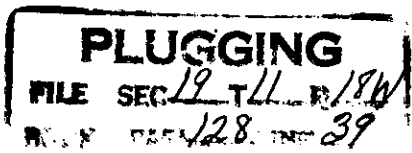

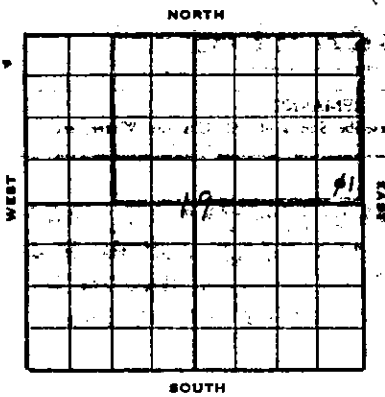

SKELLY OIL COMPANY

Well Record

Lease Name and No. **Claude D. Miller 13323** Well No. **1** Elev. **1974'**
 Lease Description **N¹/₄ and 2¹/₂ N¹/₄ of Sec. 19-118-124,**
Ellis County, Kansas

Location made **July 30,** 19**47** by **Ellis County Engineer**
 feet from North line **330** feet from East line **N¹/₄**
 feet from South line **330** feet from West line of **Sec. 19**

Work com'd. **8/4** 19**47** Rig com'd. **8/6** 19**47** Drlg. com'd. **8/7** 19**47** Drlg. com'd. **8/28** 19**47**

Rig Contractor **Claude Westworth Company**

Drilling Contractor **Claude Westworth Company, Tulsa, Oklahoma**

Rotary Drilling from **Top** to **3670'** Cable Tool Drilling from _____ to _____

Commenced Producing **DRY HOLE** 19____ Initial Prod. before shot or acid _____ Bbls.
 Initial Prod. after shot or acid _____ Bbls.

Dry Gas Well Press _____ Volume _____ Cu. ft.

Casing Head Gas Pressure _____ Volume _____ Cu. ft.

Braden Head **(13-3/8" - 13-3/8" OD)** Gas Pressure _____ Volume _____ Cu. ft.

Braden Head (_____) Gas Pressure _____ Volume _____ Cu. ft.

PRODUCING FORMATION **DRY HOLE** (Name) Top _____ Bottom _____ TOTAL DEPTH **3670'**

CASING RECORD

OD Size	Wt.	Thds.	Where Set	PULLED OUT			LEFT IN			KIND	Cond'n	CEMENTING	
				Jts.	Feet	In.	Jts.	Feet	In.			Sacks Used	Method Employed
13-3/8"	87	157'					4	132	0	Armed 34	N	125	Halliburton
8-5/8"	82	1392					43	1399	3	H40 H2 33	A	590	Halliburton
(13-3/8" casing set 6' in collar and 8-5/8" set 4' in collar)													
Spec 1 - 8-5/8" OD Larkia Combination Guide & Float 3600													

Liner Set at _____ Length _____ Perforated at _____

Liner Set at _____ Length _____ Perforated at _____

Packer Set at _____ Size and Kind _____

Packer Set at _____ Size and Kind _____

SHOT OR ACID TREATMENT RECORD

Date	FIRST		SECOND		THIRD		FOURTH	
	Ft. and	Gals. Qts.	Ft. and	Gals. Qts.	Ft. and	Gals. Qts.	Ft. and	Gals. Qts.
Shot Between								
Size of Shell								
Put in by (Co.)								
Length anchor								
Distance below Cas'g								
Damage to Casing or Casing Shoulder								

SIGNIFICANT GEOLOGICAL FORMATIONS

NAME	Top	Bottom	GAS		OIL		REMARKS
			From	To	From	To	
Andrite	1377'						
Lanning Linc	3333'						
Conglomerate	3585'						
Simpson Shale	3614'						
Simpson Sand	3632'						
Artistic Linc	3600'						

CLEANING OUT RECORDS

	DATE COMMENCED	DATE COMPLETED	PROD. BEFORE	PROD. AFTER	REMARKS
1st					See Reverse for other details.
2nd					" " " " "
3rd					" " " " "
4th					" " " " "

PLUGGING BACK AND DEEPENING RECORDS

	Date Commenced	Date Completed	No. Feet Plugged Back or Deepened	Prod. Before	Prod. After	REMARKS
1st						See Reverse for other details.
2nd						" " " " "
3rd						" " " " "
4th						" " " " "

(See Reverse for Record of Formation)

REGARD OF FORMATIONS

FORMATION	TOP	BOTTOM	REMARKS
			Indicate Casing Points, Describe Shows of Oil, Gas and Water, etc.
Surface soil and sand	0	25	
Clay, shale and sand	25	157	Set and cemented 1 1/2" OD, 4 1/2' Arco spiral hole slip joint steel casing at 157' with 125 sacks of cement and 3 sacks of equal.
Clay and shale	157	270	
Shale	270	340	
Shale and sand	340	400	
Shale and shells	400	470	
Shale and sand	470	525	
Shale and shells	525	605	
Sand	605	705	
Sand and clay	705	805	
Red bed and shale	805	1365	
Red bed	1365	1377	
Anhydrite	1377	1392	TOP ANHYDRITE 1377' Set and cemented 2-3/8" OD, 80' 1/2" thread, Grade H-40, Range 2, Janssen steel casing at 1392' with 500 sacks of cement and 11 sacks of equal.
Anhydrite	1392	1419	
Red bed and shale	1419	1529	
Shale and shells	1529	1960	
Line and shale	1960	2305	
Shale and sandy line shells	2305	2345	
Line	2345	2365	
Line and shale	2365	2560	
Line	2560	2625	
Line and shale	2625	3342	
Line	3342	3560	
Line, conglomerate & shale	3560	3640	
Dense brown and grey calcite	3640	3645	TOP LANNING LINE 3342' Set and cemented 2-3/8" OD, 80' 1/2" thread, Grade H-40, Range 2, Janssen steel casing at 3645' with 500 sacks of cement and 11 sacks of equal. Slight porosity and stains, no oil saturation
Soft grey and brown coarsely crystalline calcite	3645	3657	
Dense grey calcite	3657	3662	Porous, probable water Slight porosity, no saturation
Porous light coarsely crystalline calcite	3662	3670	probable water
TOTAL DEPTH		3670'	

Since no oil or gas was encountered in drilling to 3670', regular authority was granted to plug and abandon the location, and on August 23, 1947, the well was plugged as follows:

DEPTH	DESCRIPTION	DEPTH	DEPTH
3670'	30 sacks of cement	3670'	3670'
