

STATE OF KANSAS
STATE CORPORATION COMMISSION

WELL PLUGGING RECORD


Give All Information Completely
Make Required Affidavit
Mail or Deliver Report to:
Conservation Division
State Corporation Commission
800 Bitting Building
Wichita, Kansas

OR

Strike out upper line
when reporting plug-
ging off formations.

FORMATION PLUGGING RECORD

Ellis County. Sec. 27 Twp. 11S Rge. 18 (#) (W)
Location as "NE $\frac{1}{4}$ NW $\frac{1}{4}$ SW $\frac{1}{4}$ " or footage from lines NW/4 NE/4 SW/4
Lease Owner Mazda Oil Co.
Lease Name Henderson Well No. H-2
Office Address 404 Palace Bldg., Tulsa, Oklahoma
Character of Well (completed as Oil, Gas or Dry Hole) Rotary Dry Hole
Date well completed 12-22-48 19
Application for plugging filed 12-22-48 19
Application for plugging approved 12-22-48 19
Plugging commenced 12-22-48 19
Plugging completed 12-22-48 19
Reason for abandonment of well or producing formation Dry Hole
If a producing well is abandoned, date of last production None 19
Was permission obtained from the Conservation Division or its agents before plugging was com-
menced? Yes

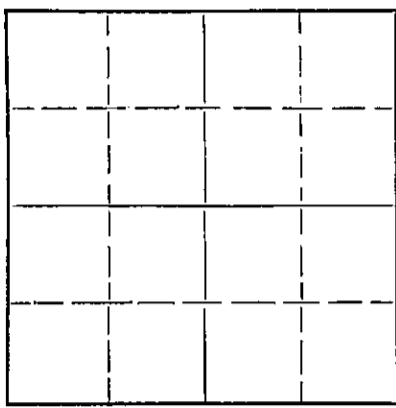

Locate well correctly on above
Section Plat

Name of Conservation Agent who supervised plugging of this well C. D. Stough
Producing formation None Depth to top Bottom Total Depth of Well Feet
Show depth and thickness of all water, oil and gas formations.

OIL, GAS OR WATER RECORDS

CASING RECORD

Formation	Content	From	To	Size	Put In	Pulled Out
Lime		0	50			
Shale		50	185			
Shale and Shells		185	1160			
Shale and Redbed		1160	1373			
A nhydrite		1373	1383	8 5/8	1390'	None

Describe in detail the manner in which the well was plugged, indicating where the mud fluid was placed and the method or methods used in introducing it into the hole. If cement or other plugs were used, state the character of same and depth placed, from feet to feet for each plug set.

Filled hole with heavy drilling mud from total depth to 200' at which point wooden plug was set and 15 sacks of cement dumped on top, filled hole from top of cement with heavy mud to within 30' of top of hole. At this point another wooden plug was set and 10 sacks of cement dumped on top filling hole to the top and in the bottom of cellar.

1-22-49

(If additional description is necessary, use BACK of this sheet)

Correspondence regarding this well should be addressed to Harbar Drilling Co.
Address 1019 Central Bldg., Wichita, Kansas

STATE OF Kansas, COUNTY OF Barton, ss.

I, H. L. King (employee or owner) or (owner or operator) of the above-described well, being first duly sworn on oath, says: That I have knowledge of the facts, statements, and matters herein contained and the log of the above-described well as filed and that the same are true and correct. So help me God.

(Signature)

Box 108, Great Bend, Kansas
(Address)

SUBSCRIBED AND SWORN TO before me this 19th day of January, 1949

My commission expires 9-4-50

Notary Public.


PLUGGING
FILE SEC 27 T 11 R 24
BOOK PAGE 27 LINE 32

HENDERSON H-2

SW $\frac{1}{4}$ of Section 27-11S-18W, Ellis County, KansasRigging up Rotary Tools 12-2-48
Tearing down Rotary Tools 12-23-48Run 69 Jts. 1390' of 8 5/8" surface pipe.
Set @ 1383' and cemented with 600 sx cement.

<u>FORMATION</u>	<u>FROM</u>	<u>TO</u>
Post Rock	0	50
Shale	50	125
Shale and shells	125	185
Sand	185	250
Salt and sand	250	315
Shale and shells	315	615
Sand	615	740
Shale and shells	740	815
Shale and sand	815	1160
Redbed and shale	1160	1190
Redbed and sand	1190	1320
Redbed and shale	1320	1373
Anhydrite	1373	1420
Shale and shells	1420	1435
Redbed	1435	1555
Shale and shells	1555	2055
Lime and shale	2055	3190
Lime	3190	3655
Conglomerate	3655	3755 Total Depth

I, Don S. Packer, hereby certify that the above log is true and correct,
to the best of my knowledge and belief.

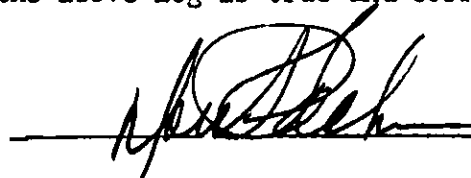

Subscribed and sworn to before me this 21st day of January 1949.



Notary Public

My commission expires: March 22, 1952.

