


STATE OF KANSAS
STATE CORPORATION COMMISSION

Form CP-4

Give All Information Completely
Make Required Affidavit
Mail or Deliver Report to:
Conservation Division
State Corporation Commission
212 No. Market
Wichita, Kansas 67202

WELL PLUGGING RECORD

Ellis County, Sec. 32 Twp. 11S Rge. ~~XXX~~ 18 (W)
Location as "NE/CNW/SWK" or footage from lines 2435' FSL, 785' FEL
Lease Owner Champlin Petroleum Company
Lease Name Johnson "L" Well No. 4
Office Address P. O. Box 308, Ellinwood, Kansas 67526
Character of Well (completed as Oil, Gas or Dry Hole) Dry Hole
Date well completed April 9, 19 71
Application for plugging filed April 10, 19 71
Application for plugging approved April 9, (Verbal) 19 71
Plugging commenced April 9 19 71
Plugging completed April 9 19 71
Reason for abandonment of well or producing formation _____

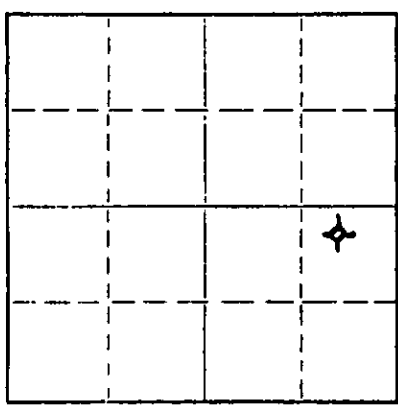

Locate well correctly on above Section Plat

If a producing well is abandoned, date of last production _____ 19____
Was permission obtained from the Conservation Division or its agents before plugging was commenced? Yes

Name of Conservation Agent who supervised plugging of this well Leo F. Massey
Producing formation _____ Depth to top _____ Bottom _____ Total Depth of Well 3670 Feet
Show depth and thickness of all water, oil and gas formations.

OIL, GAS OR WATER RECORDS

CASING RECORD

FORMATION	CONTENT	FROM	TO	SIZE	PUT IN	PULLED OUT
				8 5/8 OD	209'	None

Describe in detail the manner in which the well was plugged, indicating where the mud fluid was placed and the method or methods used in introducing it into the hole. If cement or other plugs were used, state the character of same and depth placed, from _____ feet to _____ feet for each plug set.

Filled hole with mud from 3670' TD to 600', pushed wood plug to 600' and pumped in 70 sacks cement then filled hole with mud to 210' and pumped in 20 sacks of cement then mud to 40' and dumped in 3 sacks of hulls and pumped in 10 sacks of cement filling hole to top of casing. All cement was 50-50 Pozmix, 6% Gel. Used Globe Cementing Company for cement. Job completed at 9:45 a.m. 4/9/71.

RECEIVED
STATE CORPORATION COMMISSION
APR 13 1971
CONSERVATION DIVISION
Wichita, Kansas

(If additional description is necessary, use BACK of this sheet)
Name of Plugging Contractor Red Tiger Drilling Company
Address 1720 Wichita Plaza, Wichita, Kansas

STATE OF Kansas, COUNTY OF Barton, ss.
J. W. Meyers (employee of owner) or (owner) of the above-described well, being first duly sworn on oath, says: That I have knowledge of the facts, statements, and matters herein contained and the log of the above-described well as filed and that the same are true and correct. So help me God.

(Signature) J. W. Meyers, District Operations Manager
P. O. Box 308, Ellinwood, Kansas 67526
(Address)



Subscribed and sworn to before me this 12th day of April, 19 71

My commission expires 4/16/74
N. Kenneth Stivers Notary Public.