


STATE OF KANSAS
STATE CORPORATION COMMISSION

WELL PLUGGING RECORD

Give All Information Completely
Make Required Affidavit
Mail or Deliver Report to:
Conservation Division
State Corporation Commission
212 No. Market
Wichita, Kansas

Ellis County, Sec. 32 Twp. 11S Rge. (E) 18 (W)
Ctr N/2 NE NW

Location as "NE/CNW/SW" or footage from lines
Lease Owner Champlin Petroleum Company
Lease Name Johnson "M" Well No. 1
Office Address P. O. Box 308, Ellinwood, Kansas
Character of Well (completed as Oil, Gas or Dry Hole) Dry Hole
Date well completed August 19 19 69
Application for plugging filed August 20 19 69
Application for plugging approved August 19 (verbal) 19 69
Plugging commenced August 20 19 69
Plugging completed August 20 19 69
Reason for abandonment of well or producing formation _____

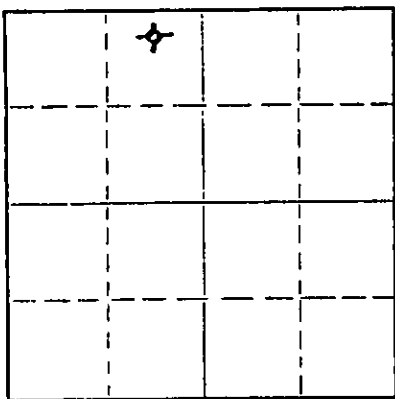

Locate well correctly on above Section Plat

If a producing well is abandoned, date of last production _____ 19____
Was permission obtained from the Conservation Division or its agents before plugging was commenced? yes

Name of Conservation Agent who supervised plugging of this well Leo F. Massey
Producing formation _____ Depth to top _____ Bottom _____ Total Depth of Well 1434 Feet
Show depth and thickness of all water, oil and gas formations.

OIL, GAS OR WATER RECORDS

CASING RECORD

FORMATION	CONTENT	FROM	TO	SIZE	PUT IN	PULLED OUT
					None	

Describe in detail the manner in which the well was plugged, indicating where the mud fluid was placed and the method or methods used in introducing it into the hole. If cement or other plugs were used, state the character of same and depth placed, from _____ feet to _____ feet for each plug set.

Filled hole with mud to 620' and pumped in 50 sacks common cement with 4% CaCl. Waited 2 hours and checked top of plug at 550' - mud to 500'. Mixed and pumped 180 sacks 50/50 Pozmix with 6% total Gel, filled hole from 500' to bottom of celler. Job complete at 4:30 a.m. 8/20/69.

STATE RECEIVED
AUG 25 1969
CONSERVATION COMMISSION
WICHITA, KANSAS

(If additional description is necessary, use BACK of this sheet)
Name of Plugging Contractor Red Tiger Drilling Company
Address 1720 Wichita Plaza, Wichita, Kansas

STATE OF Kansas COUNTY OF Barton, ss.
J. W. Meyers (employee of owner) or (owner or operator) of the above-described well, being first duly sworn on oath, says: That I have knowledge of the facts, statements, and matters herein contained and the log of the above-described well as filed and that the same are true and correct. So help me God.

(Signature) J. W. Meyers
J. W. Meyers, District Operations Manager
P. O. Box 308, Ellinwood, Kansas
(Address)

SUBSCRIBED AND SWORN TO before me this 21st day of August, 19 69

My commission expires 5/22/70
N. Kenneth Stivers Notary Public.

1505120483-0000
 RECEIVED
 STATE CORPORATION COMMISSION
 SEP 30 1969
 CONSERVATION DIVISION
 Wichita, Kansas

DRILLING LOG

No. 1 Johnson "W"

OWNER RECORD: COMPANY: Champion Petroleum Co. DESCRIPTION:
 No casing set CONTRACTOR: Red Tiger Drilling Co. C 2/3 NE SW
 22-118-15W
 COMPLETED: August 28, 1969 H11b, County,
 Kansas
 TOTAL DEPTH: 1484' COMPLETED: August 29, 1969
 ELEVATION:

FORMATION	FEET	TO	REMARKS
Shale	0	878	
Sand	878	1070	
Shale	1070	1308	
Sandstone	1308	1410	
Shale	1410	1484	

I certify that this is a true and correct record of the above log to the best of my knowledge.

RED TIGER DRILLING COMPANY

Harold E. Klein
 Harold E. Klein

Subscribed and sworn to before me this 26th day of August, 1969.



Gloria Fay Bennett
 Notary Public