


STATE OF KANSAS  
STATE CORPORATION COMMISSION

Give All Information Completely  
Make Required Affidavit  
Mail or Deliver Report to:  
Conservation Division  
State Corporation Commission  
212 No. Market  
Wichita, Kansas

WELL PLUGGING RECORD

Ellis County, Sec. 32 Twp. 11S Rge. 18 (W)

Location as "NE/CNW&SW&" or footage from lines CW/2 NE SW  
Lease Owner Champlin Petroleum Company  
Lease Name William Johnson, Jr. Well No. 1  
Office Address P. O. Box 308, Ellinwood, Kansas  
Character of Well (completed as Oil, Gas or Dry Hole) Dry Hole  
Date well completed November 24 19 68  
Application for plugging filed November 23 19 68  
Application for plugging approved November 27 19 68  
Plugging commenced November 24 19 68  
Plugging completed November 24 19 68  
Reason for abandonment of well or producing formation

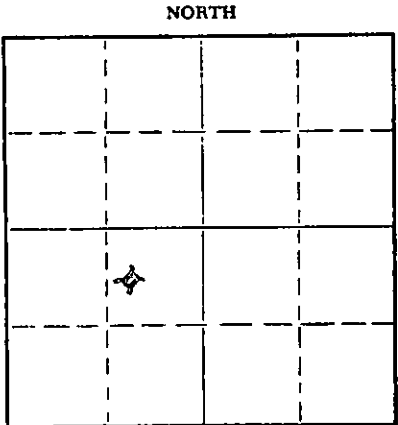

NORTH  
Locate well correctly on above Section Plat

If a producing well is abandoned, date of last production 19  
Was permission obtained from the Conservation Division or its agents before plugging was commenced? Yes

Name of Conservation Agent who supervised plugging of this well Leo Massey  
Producing formation Depth to top Bottom Total Depth of Well 3668 Feet  
Show depth and thickness of all water, oil and gas formations.

OIL, GAS OR WATER RECORDS

CASING RECORD

FORMATION	CONTENT	FROM	TO	SIZE	PUT IN	PULLED OUT
				8 5/8" OD	212'	None

Describe in detail the manner in which the well was plugged, indicating where the mud fluid was placed and the method or methods used in introducing it into the hole. If cement or other plugs were used, state the character of same and depth placed, from feet to feet for each plug set.

Filled hole with heavy rotary mud to 660' and pushed plug to 660', pumped in 70 sacks cement thru drill pipe, mudded to 210' and pumped in 20 sacks of cement, mudded to 40' and built solid bridge and pumped in 10 sacks of cement filling hole to bottom of cellar.

Used 50/50 Pozmix with 6% gel

Used Halliburton to pump cement in hole

RECEIVED  
STATE CORPORATION COMMISSION  
DEC 9 1968  
CONSERVATION DIVISION  
Wichita, Kansas

(If additional description is necessary, use BACK of this sheet)  
Name of Plugging Contractor Red Tiger Drilling Company  
Address 1720 Wichita Plaza, Wichita, Kansas

STATE OF Kansas, COUNTY OF Barton, ss.  
J. W. Meyers (employee of owner) or (owner or operator) of the above-described well, being first duly sworn on oath, says: That I have knowledge of the facts, statements, and matters herein contained and the log of the above-described well as filed and that the same are true and correct. So help me God.

(Signature) J. W. Meyers, District Operations Manager  
P. O. Box 308, Ellinwood, Kansas (Address)

SUBSCRIBED AND SWORN TO before me this 6th day of December, 19 68

My commission expires 5/22/70 N. Kenneth Stivers Notary Public.

**DRILLER'S LOG**

No. 1 Wm. Johnson, Jr.

**CASING RECORD:** 6 3/8" @ 210' 22" w/115 cc cement  
**COMPANY:** Champlin Petroleum Co.  
**CONTRACTOR:** Red Tiger Drilling Co.  
**COMMENCED:** November 10, 1968  
**COMPLETED:** November 16, 1968  
**DESCRIPTION:** C W/S NB SW 38-116-26N Ellis County, Kansas  
**TOTAL DEPTH:** 3665' **ELEVATION:**

<u>FORMATION</u>	<u>FROM</u>	<u>TO</u>	<u>REMARKS</u>
Shale - Rock - Shale	0	228	
Shale	228	350	
Sand	350	1025	
Shale	1025	1368	
Anhydrite	1368	1402	
Shale	1402	1930	
Shale & lime	1930	2780	
Lime	2780	3340	
Shale & lime	3340	3660	
Lime	3660	3665	

I certify that this is a true and correct copy of the above log to the best of my knowledge.

RED TIGER DRILLING COMPANY

*Norman E. Klein*  
 Norman E. Klein

Witnessed and sworn to before me this 3rd day of December, 1968.

*Alicia Sawcett*  
 Notary Public



*Fidelity Oil & Gas*