

STATE OF KANSAS
STATE CORPORATION COMMISSION


Give All Information Completely
Make Required Affidavit
Mail or Deliver Report to:
Conservation Division
State Corporation Commission
212 No. Market
Wichita, Kansas

WELL PLUGGING RECORD

Ellis County, Sec. 32 Twp. 11S Rge. 18 (W)

Location as "NE/CNW/SW" or footage from lines Ctr S/2 NE SE
Lease Owner Champlin Petroleum Company
Lease Name Johnson "L" Well No. 1
Office Address P. O. Box 308, Ellinwood, Kansas 67526
Character of Well (completed as Oil, Gas or Dry Hole) Dry Hole
Date well completed August 8 19 69
Application for plugging filed (Verbal) August 8 19 69
Application for plugging approved August 12 19 69
Plugging commenced August 8 19 69
Plugging completed August 8 19 69
Reason for abandonment of well or producing formation

NORTH

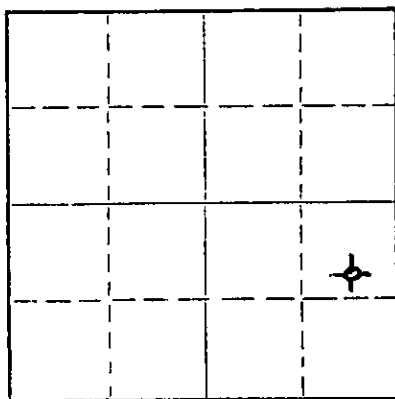

Locate well correctly on above Section Plat

If a producing well is abandoned, date of last production 19
Was permission obtained from the Conservation Division or its agents before plugging was commenced? yes

Name of Conservation Agent who supervised plugging of this well Leo Massey
Producing formation Depth to top Bottom Total Depth of Well 3300 Feet
Show depth and thickness of all water, oil and gas formations.

OIL, GAS OR WATER RECORDS

CASING RECORD

FORMATION	CONTENT	FROM	TO	SIZE	PUT IN	PULLED OUT
				8 5/8" OD	216'	None

Describe in detail the manner in which the well was plugged, indicating where the mud fluid was placed and the method or methods used in introducing it into the hole. If cement or other plugs were used, state the character of same and depth placed, from feet to feet for each plug set.

Pumped in plug and 70 sacks of 50/50 Pozmix cement with 6% total gel at 660' and 20 sacks of cement at 210'. Pushed plug and 1/2 sack of hulls to 40' and pumped in 10 sacks of cement filling hole to bottom of cellar. Job completed at 10:45 a.m. 8/8/69. Used Globe Cementing Company - all cement was 50/50 Pozmix.

RECEIVED
STATE CORPORATION COMMISSION
AUG 15 1969
CONSERVATION DIVISION
Wichita, Kansas

(If additional description is necessary, use BACK of this sheet)
Name of Plugging Contractor Red Tiger Drilling Company
Address 1720 Wichita Plaza, Wichita, Kansas 67202

STATE OF Kansas, COUNTY OF Barton, ss.
J. W. Meyers (employee of owner) or (owner/operator) of the above-described well, being first duly sworn on oath, says: That I have knowledge of the facts, statements, and matters herein contained and the log of the above-described well as filed and that the same are true and correct. So help me God.

(Signature) J. W. Meyers, District Operations Manager
P. O. Box 308, Ellinwood, Kansas 67526
(Address)

SUBSCRIBED AND SWORN TO before me this 14th day of August, 19 69

My commission expires 5/22/70
N. Kenneth Stivers Notary Public.

DRILLERS LOG

CASINO RECORD:

COMPANY:

Champion Petroleum Co.

DESCRIPTION:

2 1/2" @ 215.00'
w/372 oz cement

CONTRACTOR:

Red Tiger Drilling Co.

Q 2, 2 NE SW
22-11-16
Hills County,
Kansas

COMMENCED:

August 2, 1969

COMPLETED:

August 6, 1969

ELEVATION:

TOTAL DEPTH: 2100'

FORMATION

FROM

TO

REMARKS

Shale & Sand
Sand
Shale
Anhydrite
Shale
Shale
Lime & Shale
Lime

0
225
1025
1281
1381
1400
2080
2080

225
1025
1281
1400
2080
2080

I certify that this is a true and correct copy of the above log to the best of my knowledge.

RED TIGER DRILLING COMPANY

Norman E. Klein
Norman E. Klein

Subscribed and sworn to before me this 14th day of August, 1969.

John Stebbins
Notary Public

My Commission Expires:
8-25-72

RECEIVED
STATE CORPORATION COMMISSION
AUG 18 1969
CONSERVATION DIVISION
Wichita, Kansas

Fidelity Union Bank