

STATE OF KANSAS
STATE CORPORATION COMMISSION

WELL PLUGGING RECORD


Give All Information Completely
Make Required Affidavit
Mail or Deliver Report to:
Conservation Division
State Corporation Commission
800 Bittling Building
Wichita, Kansas

OR

FORMATION PLUGGING RECORD

Strike out upper line
when reporting plugging
off formations.

NORTH

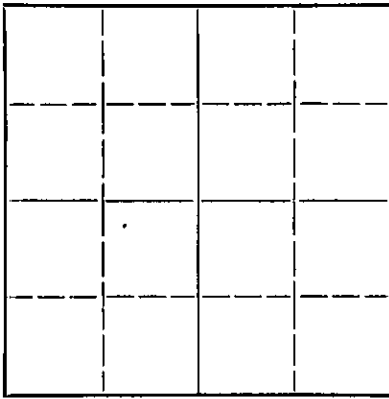

Locate well correctly on above
Section Plat

Ellis County. Sec. 22 Twp. 11 Rge. 18 (W)
Location as "NE1/4NW1/4SW1/4" or footage from lines. Sec NW NW
Lease Owner. Champlin Refining Co.
Lease Name. Johnson Well No. 1-C
Office Address. Enid, Okla.
Character of Well (completed as Oil, Gas or Dry Hole) Dry Hole
Date well completed. 19...
Application for plugging filed. 8-8-44 19...
Application for plugging approved. 8-8-44 19...
Plugging commenced. 8-3-44 19...
Plugging completed. 8-3-44 19...
Reason for abandonment of well or producing formation. Dry Hole
If a producing well is abandoned, date of last production. Dry Hole 19...
Was permission obtained from the Conservation Division or its agents before plugging was commenced? Yes

Name of Conservation Agent who supervised plugging of this well. Eldon Petty
Producing formation. Depth to top. Bottom. Total Depth of Well. 3760 Feet
Show depth and thickness of all water, oil and gas formations.

OIL, GAS OR WATER RECORDS

CASING RECORD

Formation	Content	From	To	Size	Put In	Pulled Out

Describe in detail the manner in which the well was plugged, indicating where the mud fluid was placed and the method or methods used in introducing it into the hold. If cement or other plugs were used, state the character of same and depth placed, from...feet to...feet for each plug set.

Heavy mud 3760 to 1240'
Cement to 1190' Mud and Bridge to 30'
Cement to 5'
1240' of 8 5/8 left in hole cemented to surface.

(If additional description is necessary, use BACK of this sheet)

Correspondence regarding this well should be addressed to Champlin Refining Co.
Address. Enid, Okla.

STATE OF Okla., COUNTY OF Garfield, ss.
F. C. Wentworth (employee of owner) or (owner or operator) of the above-described well,
being first duly sworn on oath, says: That I have knowledge of the facts, statements, and matters herein contained and the log of the above-described well as filed and that the same are true and correct. So help me God.

(Signature) *F. C. Wentworth*

(Address)

SUBSCRIBED AND SWORN to before me this 16th day of February, 1948

My commission expires May 19, 1951 Notary Public.

PLUGGING
FILE SEC 32-T-11-R 180
BOOK PAGE 127 LINE 11

(For use in Kansas Only for reporting formation record)

WELL RECORD

N

		32			

COUNTY Ellis SEC. 32 TWP. 11S RGE. 18W
 COMPANY OPERATING Champlin Refining Company
 OFFICE ADDRESS Enid, Oklahoma
 FARM NAME Johnson "C" WELL NO. 1
 WELL LOCATED Southeast quarter of Northwest quarter of Northwest quarter of Sec. 32-11S-18W.
 CHARACTER OF WELL Dryhole

Date commenced 6-13-44
 Date completed 8-5-44

CASING RECORD

SIZE	WT.	THDS.	MAKE	FT.	IN.	AMOUNT PULLED	CEMENT
8 ⁵ / ₈	32 ⁷ / ₈	8V	Lapweld	1247'	9"	None	350 sacks

FORMATION RECORD

FORMATION	TOP	BOTTOM	FORMATION	TOP	BOTTOM
Rock	0	35			
Shale, Shells	35	865			
Sand	865	1065			
Shale, Shells	1065	1185			
Redbed, Shale	1185	1368			
Lime	1368	1402			
Shale, Shells, Redbed	1402	1610			
Shale, Salt	1610	1890			
Shale, Shells	1890	2235			
Shale, Lime	2235	3090			
Lime	3090	3125			
Shale	3125	3150			
Lime	3150	3575			
Lime, Shale	3575	3608			
Shale, Sand, Chert	3608	3635			
Chert, Lime	3635	3675			
Lime	3675	3710			
Shale, Lime	3710	3745			
Lime	3745				

Tops

Topeka	-----	3094
Lansing	-----	3342
Arbuckle	-----	3708

Total Depth 3745 feet
 Hole plugged and abandoned as Dryhole.

RECORDED
 FEB 17 1948

F. B. Westworth
 Superintendent

Subscribed and sworn to before me this
10th day of August 1948

N. E. Miller
 Notary Public

PLUGGING
 FILE SEC 32 T 11 N 18 W
 BOOK PAGE 127 LINE 11

My commission expires Dec. 7, 1945