


15-135-20939-0000

STATE OF KANSAS
STATE CORPORATION COMMISSION

Form CP-4

Give All Information Completely
Make Required Affidavit
Mail or Deliver Report to:
Conservation Division
State Corporation Commission
P. O. Box 17027
Wichita, Kansas 67217
NORTH

WELL PLUGGING RECORD

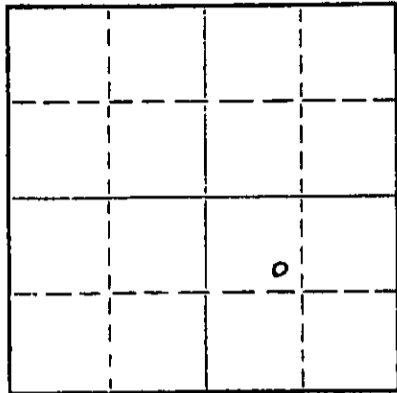

Locate well correctly on above
Section Plat

NESS County, Sec. 20 Twp. 19S Rge. 24W (E) (W)
Location as "NE/CNWKSW" or footage from lines SE NW SE
Lease Owner Donald C. Slawson
Lease Name Mellies "E" Well No. 1
Office Address 408 120 Building, Wichita, Kansas 67202
Character of Well (completed as Oil, Gas or Dry Hole) Dry Hole
Date well completed September 23 1974
Application for plugging filed September 23 1974
Application for plugging approved September 23 1974
Plugging commenced September 23 1974
Plugging completed September 23 1974
Reason for abandonment of well or producing formation Dry Hole

If a producing well is abandoned, date of last production 19
Was permission obtained from the Conservation Division or its agents before plugging was commenced? Yes

Name of Conservation Agent who supervised plugging of this well W.L. Nichols, P.O. Box 157, Morland, KS 67650
Producing formation Depth to top Bottom Total Depth of Well 4432 Feet
Show depth and thickness of all water, oil and gas formations.

OIL, GAS OR WATER RECORDS

CASING RECORD

FORMATION	CONTENT	FROM	TO	SIZE	PUT IN	PULLED OUT
8 5/8"	285'			285'		

Describe in detail the manner in which the well was plugged, indicating where the mud fluid was placed and the method or methods used in introducing it into the hole. If cement or other plugs were used, state the character of same and depth placed, from feet to feet for each plug set.

1st Plug @850' w/80 sx
2nd Plug @310' w/35 sx
3rd Plug @40' w/15 sx

RECEIVED
STATE CORPORATION COMMISSION
UL-4
1974
CONSERVATION DIVISION
Wichita, Kansas


(If additional description is necessary, use BACK of this sheet)

Name of Plugging Contractor Slawson Drilling Company, Inc.
Address 408 120 Building, Wichita, Kansas 67202

STATE OF KANSAS, COUNTY OF SEDGWICK, ss.
James C. Remsberg (employee of owner) or (owner or operator) of the above-described well, being first duly sworn on oath, says: That I have knowledge of the facts, statements, and matters herein contained and the log of the above-described well as filed and that the same are true and correct. So help me God.

(Signature) James C. Remsberg
James C. Remsberg
(Address)

I, SUBSCRIBED AND SWORN to before me this 3rd day of October 1974

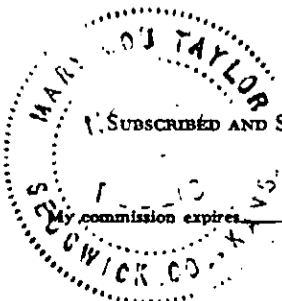

Mary Lou Taylor
Notary Public.

WELL LOG

COMPANY: Donald C. Slawson
 408 120 Building
 Wichita, Kansas 67202

LEASE: Mellies "E" #1
 SE-NW-SE Sec. 20-19S-24W
 Ness County, Kansas

TOTAL DEPTH: 4432 feet

CONTRACTOR: Slawson Drilling Company, Inc.

COMMENCED: September 13, 1974

COMPLETED: September 23, 1974

CASING: Set 8 5/8" @285' w/225 sx

RECEIVED
 STATE CORPORATION COMMISSION
 OCT 4 1974
 CONSERVATION DIVISION
 Wichita, Kansas

0-300	Shale and Shells
300-1580	Shale
1580-1627	Anhydrite
1627-1790	Shale
1790-2235	Shale and Shells
2235-3790	Lime and Shale
3790-4432	Lime
4432	RTD

STATE OF KANSAS)
) SS.
 COUNTY OF SEDGWICK)

I, JAMES C. REMSBERG, of the Slawson Drilling Company, Inc. upon oath state that the above and foregoing is a true and correct copy of the log of the Mellies "E" #1 well.

James C. Remsberg
 JAMES C. REMSBERG

Subscribed and sworn to before me this 3rd day of October, 1974.



Mary Lou Taylor
 Mary Lou Taylor, Notary Public

My Commission Expires: 1-17-77